


FOUND IRON PINS

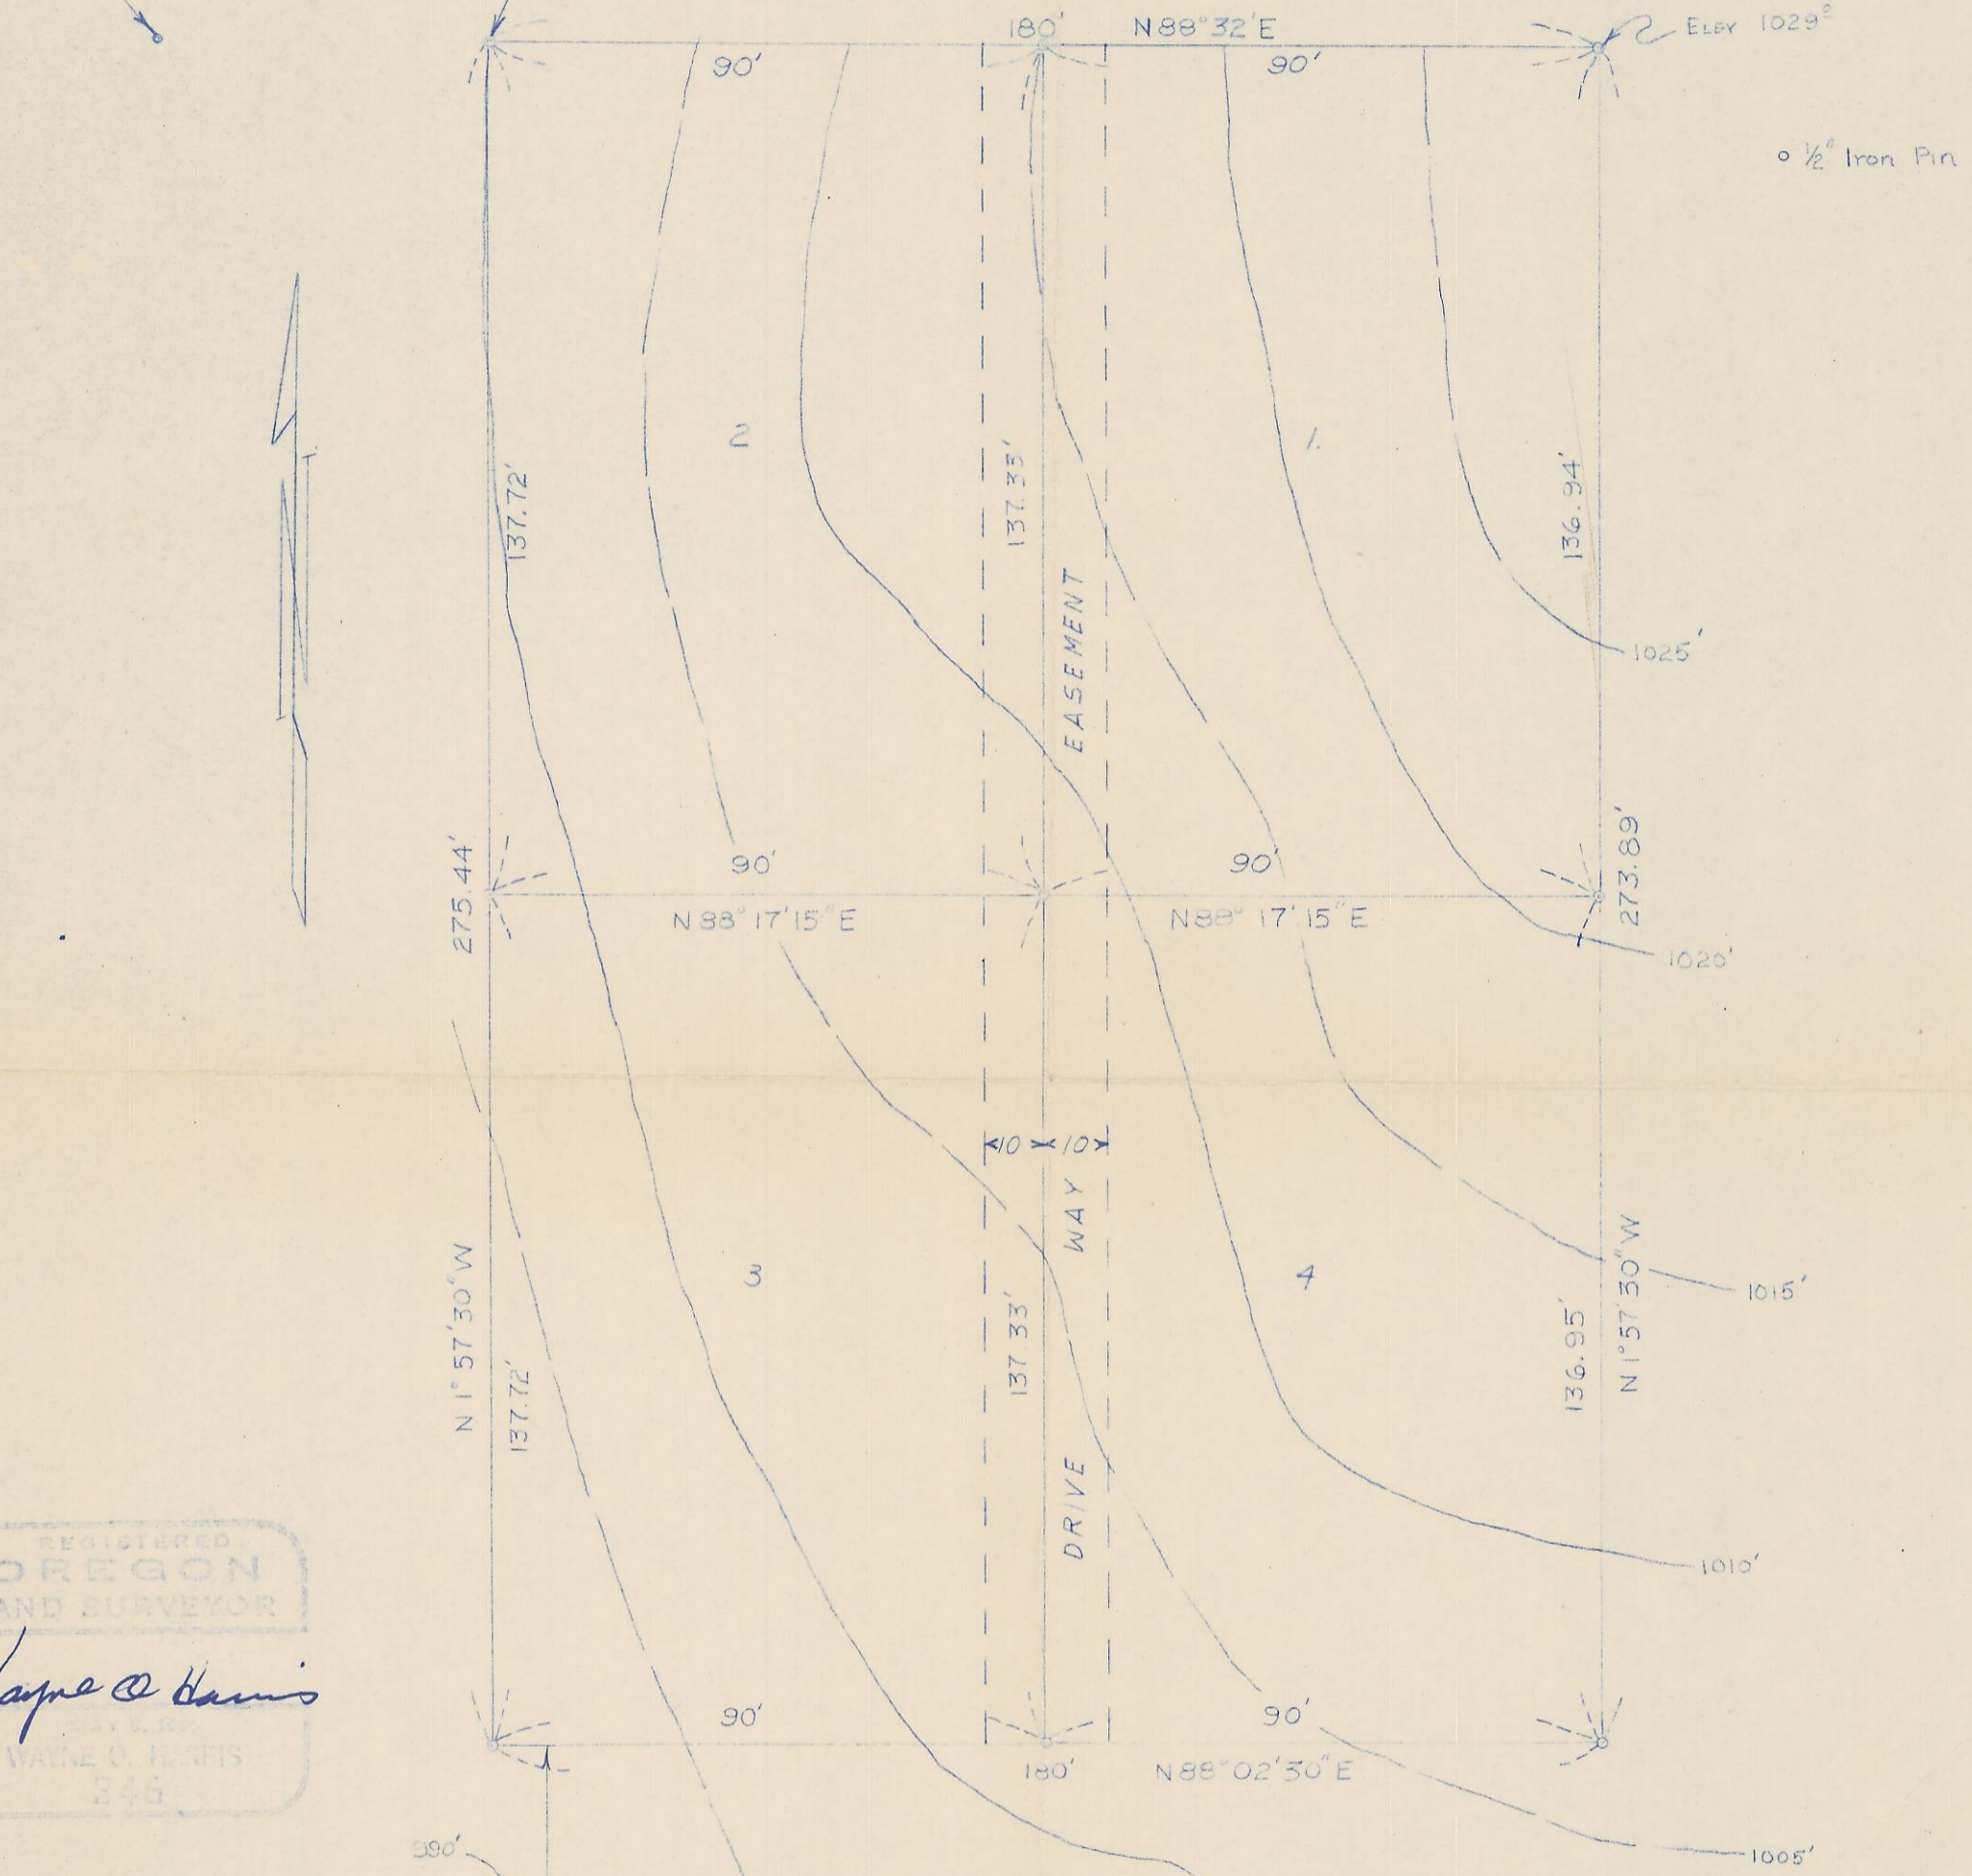

REGISTERED  
OREGON  
LAND SURVEYOR  
*Wayne O. Harris*  
WAYNE O. HARRIS  
346

FOUND IRON PIPE - 1<sup>3</sup>/<sub>8</sub> FEET WEST  
OF TIES TO PINS FND-PIPE  
CHECKS NORTH-SOUTH PLATTED  
DISTANCE

NOTE - EAST NUT ON TOP  
OF FIRE HYDRANT USED AS  
T.B.M. - ASSUMED ELEV.  
IS 1000<sup>00</sup>

NW<sup>1</sup> SE<sup>4</sup> (3) DA

HAYES AND HARRIS			
SURVEY FOR			
E. W. BARNUM			
LOT 3	BLOCK 1		
STANGIER HILLS ADDITION			
PENDLETON, OREGON			
SCALE	DATE	DRN. BY	DRNG. NO.
1" = 30'	10/6/60	L. H. A.	

205

Q-137-A

Q-137-A