


LEGEND

- - SET 5/8" x 30" I. PIN W/ALUM. OR PLASTIC CAP MARKED "WALLULIS & ASSOC. INC."
 - - MONUMENTS FOUND AS NOTED.
- FOR ADDITIONAL INFORMATION SEE SURVEY MAP NO. 82-60-B AS RECORDED IN COUNTY SURVEYOR'S OFFICE & THE ATTACHED NARRATIVE OF SURVEY ELEVATIONS ARE BASED ON 1929 SEA LEVEL DATUM.
BEARINGS ARE TRUE BASED ON TIES TO USC&GS STA "MISSION".



SCALE: 1" = 60'

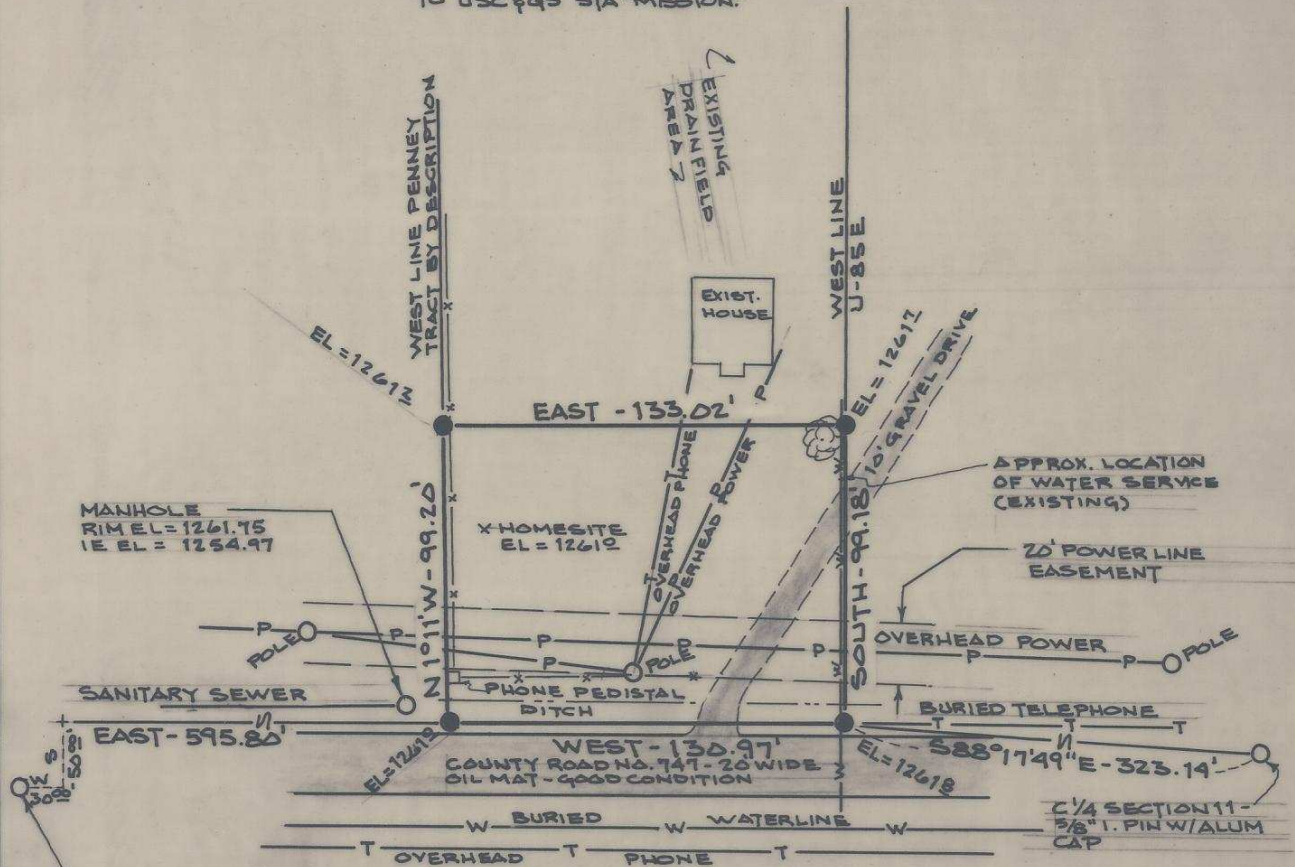

MANHOLE
RIM EL = 1261.75
IE EL = 1254.97

X-HOMESITE
EL = 12610

APPROX. LOCATION
OF WATER SERVICE
(EXISTING)

20' POWER LINE
EASEMENT

SANITARY SEWER

EAST - 595.80'

WEST - 130.97'
COUNTY ROAD NO. 747 - 20 WIDE
OIL MAT - GOOD CONDITION

BURIED TELEPHONE

588°17'49" E - 323.14'

C 1/4 SECTION 11 -
5/8" I. PIN W/ALUM
CAP

FOUND BRASS CAP ON
1 1/2" I. PIPE WITNESS COR.
LOCATED 50' S & 30' W
WEST OF NE COR OF
THE UMATILLA AGENCY
RESERVE.

REGISTERED
PROFESSIONAL
LAND SURVEYOR

William R. Wells

OREGON
JULY 22, 1977
WILLIAM R. WELLS
1106

RECEIVED BY

Umatilla County Surveyor

Date 9-10-82

Rec'd by *BFS*

No. 82-76-Ax

PARCEL LOCATED IN THE SE 1/4 NW 1/4
SECTION 11, TWP 2 NORTH, R4E 35E EAST, W.M.
UMATILLA COUNTY, OREGON

UMATILLA RESERVATION HOUSING AUTHORITY

PROJECT 12-07

APPLICANTS NAME: LORA LEE PENNEY

SITE NO. 15

DWELLING UNIT TYPE

WALLULIS & ASSOCIATES, INC., 213 S.W. EMIGRANT, PENDLETON, OR. (503)-276-1598

82-76-Ax

NARRATIVE OF SURVEY

for

LORA LEE PENNEY
(See Map of Survey No. 82-76-AX)

This survey was performed for the Umatilla Reservation Housing Authority as part of the 12-07 housing construction project. The survey involved laying out a tract of land for a new homesite within the boundaries of Lora Lee Penney's ownership.

The description for Lora Lee Penney's land overlaps allotment U-85-E by approximately 11 feet at the Southeast corner of the Penney lot and there is a gap between the Penney description and allotment U-85-F of approximately 23 feet at the Southwest corner of the Penney ownership. The BIA Realty Department has been advised of the situation. In order to complete this survey, we have excluded areas of overlap from the new homesite tract description.

The South and West boundaries of this tract were laid out as per the Penney description. The North line of the tract is an East-west line within the overall boundary of the Penney ownership. The East line of the tract was laid out along the Westerly line of the description for allotment U-85-E, thus eliminating overlap in the homesite description.

For additional information concerning monuments found within Section 11, see Map of Survey No. 82-60-B as recorded in the Office of the Umatilla County Surveyor.

The right-of-way of County Road Number 747 was excluded from the tract description.

REGISTERED
PROFESSIONAL
LAND SURVEYOR

William R. Wells

OREGON
JULY 22, 1977
WILLIAM R. WELLS
1106

RECEIVED BY
Umatilla County Surveyor
Date 10-82
Rec'd By BLS
No. 82-76-AX