

OREGON CORNER RESTORATION FORM

Section: 29, 32
County: Umatilla

Township: 3N
Date: 10/11/2011

Range: 33E

Corner Designation: 3N33V07

Quarter corner common to Sections 29, 32, T3NR33E.


	Condition Report Only
X	Not Found
X	Remonumented
	Unrecorded
X	Surveyed In
X	Referenced Out

Previous Renewals / Surveys, etc.


Originally surveyed by Chaplin in 1864. He set a 12" x 8" x 8" stone.
 In 1871 Moody set a 20" x 10" x 6" stone.
 In 1887 Currin and Noland set a 9" x 8" x 7" stone with pits East and West and a mound of earth.
 In 1887 Currin and Noland found a 9" x 5" x 7" stone.
 In 1904 J. Kimbrell found the corner in Private Survey #180 as recorded in Book #1, pp. 526, 527.

Monuments and Accessories Found: (Condition and Source):
None.

Diagram

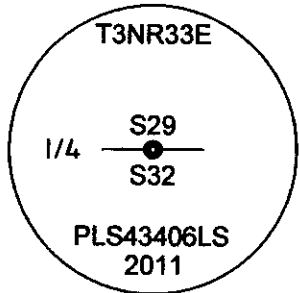

Sketch

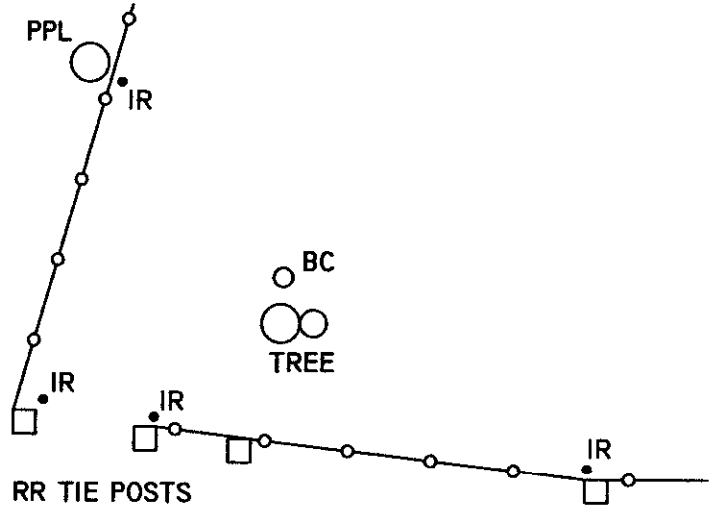

NAD 83/91
OREGON STATE PLANE NORTH
INTERNATIONAL FEET

N747582.62
E8658211.09

Monument(s) Set (Procedures and Description):

A 1 1/8" galvanized iron pipe with 2 1/2" brass cap, stamped as shown above, 1.3' below the surface.
 The corner location was reestablished by single proportionate method between neighboring found monuments to the East and West. The monument was set by swing ties from 27.00' South and 22.00' West.

References Set:

- A 5/8" x 30" iron rebar w/RPC #43406 lies N 39° 25' W, 65.75', at a power pole.
- A 5/8" x 30" iron rebar w/RPC #43406 lies S 56° 40' E, 90.99', at a railroad tie post.
- A 5/8" x 30" iron rebar w/RPC #43406 lies S 47° 10' W, 42.55', at a railroad tie post.
- A 5/8" x 30" iron rebar w/RPC #43406 lies S 63° 30' W, 57.17', at a railroad tie corner post.
- A cottonwood tree with a double-vee at the base, measuring 20" and 14", lies S 20° E, M/L, 12.50'.

Location and Comments:

The corner is located 1/3 mile, M/L, South Southwest of the intersection of Adams Rd. and Myrick Rd.

Compass Declination

17° E

Surveyors Seal

REGISTERED
PROFESSIONAL
LAND SURVEYOR

Robert D. English
OREGON
JANUARY 11, 2005
ROBERT DOUGLAS ENGLISH
43406LS

RENEWAL DATE: 12/31/13

RECEIVED BY:

Date: 7/10/2012
 Rec'd By: S. Oles
 No. 12-094-C

Firm / Agency

Survey One, LLC.
 P.O. Box 382
 Pendleton, OR 97801
 (541) 276-2055