

OREGON CORNER RESTORATION FORM

Section 14 Township 5N Range 36E
 County Umatilla Date: November 21, 2011

Corner Designation: 5N36N19

Condition Report Only
 Not found

Quarter corner common to sections 14 and 23,
 T5N, R36E, W.M., Umatilla County, Oregon.

Remonumented
 Unrecorded
 Surveyed in
 Referenced out


Previous Renewals / Surveys, etc.

Corner originally set by Odell and Lewis under contract No. 110 dated February 7, 1865. Their record reads: Set 1/4 Sec. post, drove charred stake, dug pits and raised mound as per instructions. John Kimbrell in the Record of Private Surveys Book 1, Page 374 states: set stone in mound of stone for 1/4 sec. cor.; Willard Bradley in his 1911 survey for Obert states: Cor. stone mound. Dave Krumbein in survey 85-148-B states: Old stake in N - S fence.

Monument and Accessories found: (condition and source)


The north - south fence. The area has been plowed for water lines in a fruit orchard.

DIAGRAM

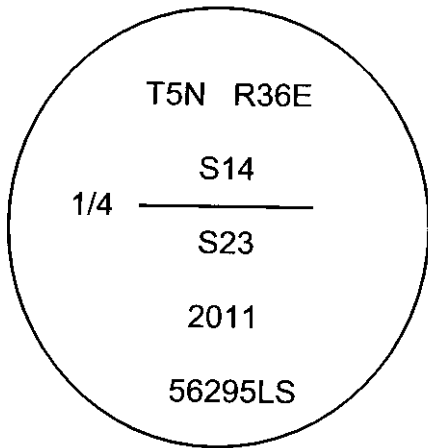

- ⊙ = Brass cap.
- = Steel guard post.
- = Rebar reference.

SKETCH
 N. T. S.

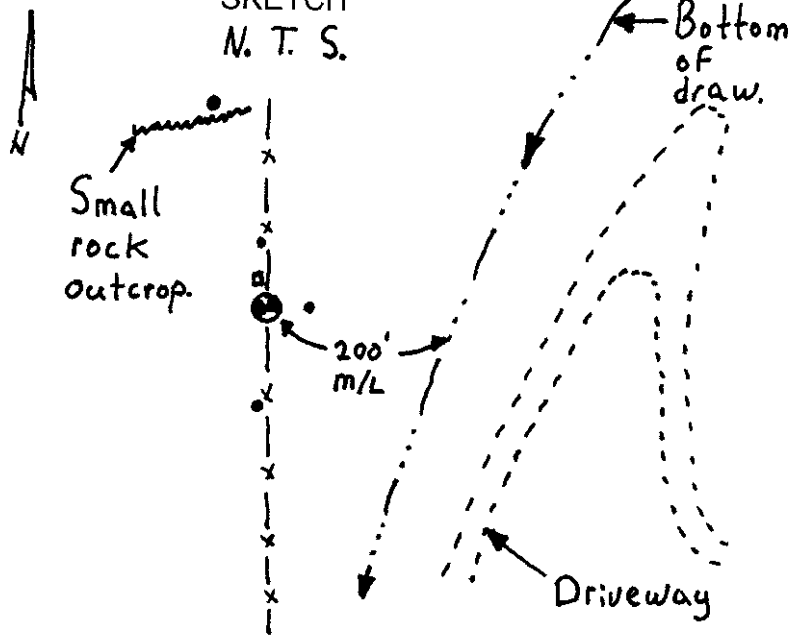

MONUMENT (S) AND ACCESSORIES SET (Procedures and Description)

At a position determined by the fence, ties to survey 85-148-B and the projection of the section line between the SW corner of Section 14 and the West 1/16th between 14 and 23, I set a 2 1/4" brass cap on a 1 1/2"x30" galvanized iron pipe flush with the surface of the ground.

For references, I set four 5/8" by 24" iron rebars with 1 1/4" orange plastic caps stamped WTS and 56295LS as described below:

- an iron rebar bears S1°18'59"E, 22.48 feet, under the existing fence;
- an iron rebar bears N82°28'49"E, 20.58 feet;
- an iron rebar bears N2°56'00"W, 45.32 feet, under the existing fence;
- an iron rebar bears N6°24'24"W, 218.46 feet, driven in a crack in a small rock outcrop;

The monument was set and references tied using a Trimble R7/R8 RTK GPS system.

Location and comments

Compass Declination

Surveyors Seal

NAD 83/1991 State Plane Coordinate

Oregon North Zone

N = 823618.96 ift

E = 8767495.58 ift

Firm / Agency

Witness Tree Surveying

Address

P.O. Box G

Pilot Rock, Or. 97868

Party Chief

Stephen K, Haddock

REGISTERED
 PROFESSIONAL
 LAND SURVEYOR

Stephen K. Haddock

OREGON
 JULY 9, 2001
 STEPHEN K. HADDOCK
 56295LS

RENEWAL DATE 6-30-13

RECEIVED BY:

Umatilla County Surveyor

Date: 6/5/2012

Rec'd By: A. Per

No. 12-088-C