Page 1 of 5 LOMR-APP Issue Date: August 17, 2009 Effective Date: August 17, 2009 Case No.: 09-10-0493P

Follows Conditional Case No.: 05-10-0750R



### Federal Emergency Management Agency

Washington, D.C. 20472

#### LETTER OF MAP REVISION **DETERMINATION DOCUMENT**

COMMUNITY AND REVISION INFORMATION		PROJECT DESCRIPTION	BASIS OF REQUEST			
COMMUNITY	City of Stanfield Umatilla County Oregon		LEVEE	FLOODWAY HYDRAULIC ANALYSIS NEW TOPOGRAPHIC DATA		
	COMMUNITY NO.: 410213					
IDENTIFIER	City of Stanfield Flood Protect	on Plan - Stage Gulch Ditch	APPROXIMATE LATITUDE & LONGITUDE: 45.782, -122.783 SOURCE: Precision Mapping Streets DATUM: NAD 27			
ANNOTATED MAPPING ENCLOSURES			ANNOTATED STU	ANNOTATED STUDY ENCLOSURES		
TYPE: FIRM*	NO.: 410213 0001 C	DATE: September 4, 1986	DATE OF EFFECTIVE FLOOD INSURANCE STUDY: September 4, 1986 PROFILE(S): 02P FLOODWAY DATA TABLE: 2			

#### FLOODING SOURCE(S) & REVISED REACH(ES)

Stage Gulch Ditch - from approximately 150 feet downstream of Umatilla Street to approximately 2,720 feet upstream of South Edwards Road

SUMMARY OF REVISIONS				
Flooding Source	Effective Flooding	Revised Flooding	Increases	Decreases
Stage Gulch Ditch	Zone AE	Zone AE	NONE	YES
	Floodway	Floodway	YES	YES
	BFEs*	BFEs	NONE	YES
	Zone X (shaded)	Zone X (shaded)	NONE	YES
* BFFs - Base Flood Flevations				

#### **DETERMINATION**

This document provides the determination from the Department of Homeland Security's Federal Emergency Management Agency (FEMA) regarding a request for a Letter of Map Revision (LOMR) for the area described above. Using the information submitted, we have determined that a revision to the flood hazards depicted in the Flood Insurance Study (FIS) report and/or National Flood Insurance Program (NFIP) map is warranted. This document revises the effective NFIP map, as indicated in the attached documentation. Please use the enclosed annotated map panels revised by this LOMR for floodplain management purposes and for all flood insurance policies and renewals in your community.

This determination is based on the flood data presently available. The enclosed documents provide additional information regarding this determination. If you have any questions about this document, please contact the FEMA Map Assistance Center toll free at 1-877-336-2627 (1-877-FEMA MAP) or by letter addressed to the LOMC Clearinghouse, 6730 Santa Barbara Court, Elkridge, MD 21075. Additional Information about the NFIP is available on our website at http://www.fema.gov/nfip.

Enclosures reflect changes to flooding sources affected by this revision.

\* FIRM - Flood Insurance Rate Map; \*\* FBFM - Flood Boundary and Floodway Map; \*\*\* FHBM - Flood Hazard Boundary Map

Page 2 of 5 Issue Date: August 17, 2009 Effective Date: August 17, 2009 Case No.: 09-10-0493P LOMR-APP



## Federal Emergency Management Agency

Washington, D.C. 20472

# LETTER OF MAP REVISION DETERMINATION DOCUMENT (CONTINUED)

#### OTHER COMMUNITIES AFFECTED BY THIS REVISION

CID Number: 410204 Name: Umatilla County, Oregon

AFFECTED MAP PANELS	AFFECTED PORTIONS OF THE FLOOD INSURANCE STUDY REPORT			
TYPE: FIRM* NO.: 410204 0400 B DATE: March 4, 1987	DATE OF EFFECTIVE FLOOD INSURANCE STUDY: September 8, 1999 PROFILE(S): 15P FLOODWAY DATA TABLE: 2			

This determination is based on the flood data presently available. The enclosed documents provide additional information regarding this determination. If you have any questions about this document, please contact the FEMA Map Assistance Center toll free at 1-877-336-2627 (1-877-FEMA MAP) or by letter addressed to the LOMC Clearinghouse, 6730 Santa Barbara Court, Elkridge, MD 21075. Additional Information about the NFIP is available on our website at http://www.fema.gov/nfip.

**Engineering Management Branch** 

Mitigation Directorate

Siamak Esfandiary, Ph.D., P.E., CFM, Program Specialist

112553 10.3.1.09100493 102-D-A

Page 3 of 5 | Issue Date: August 17, 2009 | Effective Date: August 17, 2009 | Case No.: 09-10-0493P | LOMR-APP



### Federal Emergency Management Agency

Washington, D.C. 20472

## LETTER OF MAP REVISION DETERMINATION DOCUMENT (CONTINUED)

#### **COMMUNITY INFORMATION**

#### APPLICABLE NFIP REGULATIONS/COMMUNITY OBLIGATION

We have made this determination pursuant to Section 206 of the Flood Disaster Protection Act of 1973 (P.L. 93-234) and in accordance with the National Flood Insurance Act of 1968, as amended (Title XIII of the Housing and Urban Development Act of 1968, P.L. 90-448), 42 U.S.C. 4001-4128, and 44 CFR Part 65. Pursuant to Section 1361 of the National Flood Insurance Act of 1968, as amended, communities participating in the NFIP are required to adopt and enforce floodplain management regulations that meet or exceed NFIP criteria. These criteria, including adoption of the FIS report and FIRM, and the modifications made by this LOMR, are the minimum requirements for continued NFIP participation and do not supersede more stringent State/Commonwealth or local requirements to which the regulations apply.

We provide the floodway designation to your community as a tool to regulate floodplain development. Therefore, the floodway revision we have described in this letter, while acceptable to us, must also be acceptable to your community and adopted by appropriate community action, as specified in Paragraph 60.3(d) of the NFIP regulations.

#### **COMMUNITY REMINDERS**

We based this determination on the 1-percent-annual-chance flood discharges computed in the FIS for your community without considering subsequent changes in watershed characteristics that could increase flood discharges. Future development of projects upstream could cause increased flood discharges, which could cause increased flood hazards. A comprehensive restudy of your community's flood hazards would consider the cumulative effects of development on flood discharges subsequent to the publication of the FIS report for your community and could, therefore, establish greater flood hazards in this area.

Your community must regulate all proposed floodplain development and ensure that permits required by Federal and/or State/Commonwealth law have been obtained. State/Commonwealth or community officials, based on knowledge of local conditions and in the interest of safety, may set higher standards for construction or may limit development in floodplain areas. If your State/Commonwealth or community has adopted more restrictive or comprehensive floodplain management criteria, those criteria take precedence over the minimum NFIP requirements.

We will not print and distribute this LOMR to primary users, such as local insurance agents or mortgage lenders; instead, the community will serve as a repository for the new data. We encourage you to disseminate the information in this LOMR by preparing a news release for publication in your community's newspaper that describes the revision and explains how your community will provide the data and help interpret the NFIP maps. In that way, interested persons, such as property owners, insurance agents, and mortgage lenders, can benefit from the information.

This determination is based on the flood data presently available. The enclosed documents provide additional information regarding this determination. If you have any questions about this document, please contact the FEMA Map Assistance Center toll free at 1-877-336-2627 (1-877-FEMA MAP) or by letter addressed to the LOMC Clearinghouse, 6730 Santa Barbara Court, Elkridge, MD 21075. Additional Information about the NFIP is available on our website at http://www.fema.gov/nfip.

**Engineering Management Branch** 

Mitigation Directorate

Siamak Esfandiary, Ph.D., P.E., CFM, Program Specialist

Page 4 of 5 | Issue Date: August 17, 2009 | Effective Date: August 17, 2009 | Case No.: 09-10-0493P | LOMR-APP



### Federal Emergency Management Agency

Washington, D.C. 20472

## LETTER OF MAP REVISION DETERMINATION DOCUMENT (CONTINUED)

We have designated a Consultation Coordination Officer (CCO) to assist your community. The CCO will be the primary liaison between your community and FEMA. For information regarding your CCO, please contact:

Mr. Mark Carey
Director, Mitigation Division
Federal Emergency Management Agency, Region X
Federal Regional Center
130 228th Street, Southwest
Bothell, WA 98021-8627
(425) 487-4682

#### STATUS OF THE COMMUNITY NFIP MAPS

We are processing a revised FIRM and FIS report for the incorporated and unincorporated areas of Umatilla County in our countywide format; therefore, we will not physically revise and republish the FIS report for your community to incorporate the modifications made by this LOMR at this time. Preliminary copies of the countywide FIRM and FIS report, which present information from the effective and FIS reports for your community and other incorporated communities in Umatilla County, were submitted to your community for review on January 30, 2009. We will incorporate the modifications made by this LOMR into the countywide FIRM and FIS report before they become effective.

As part of this revision, the format of the map panel has changed. Previously, flood-hazard information was shown on both the FIRM and FBFM. In the new format, all BFEs, cross sections, zone designations, and floodplain and floodway boundary delineations shown on the FIRM and the FBFM have been eliminated. Some of the flood insurance zone designations were changed to reflect the new format. Areas previously shown as Zone A were changed to Zone AE. Areas previously shown as Zone B were changed to Zone X (shaded). Areas previously shown as Zone C were changed to Zone X (unshaded). In addition, all zone designations and reach determinations were removed from the profile panels.

This determination is based on the flood data presently available. The enclosed documents provide additional information regarding this determination. If you have any questions about this document, please contact the FEMA Map Assistance Center toll free at 1-877-336-2627 (1-877-FEMA MAP) or by letter addressed to the LOMC Clearinghouse, 6730 Santa Barbara Court, Elkridge, MD 21075. Additional Information about the NFIP is available on our website at http://www.fema.gov/nfip.

8-fepry

Siamak Esfandiary, Ph.D., P.E., CFM, Program Specialist Engineering Management Branch Mitigation Directorate Page 5 of 5 | Issue Date: August 17, 2009 | Effective Date: August 17, 2009 | Case No.: 09-10-0493P | LOMR-APP



### Federal Emergency Management Agency

Washington, D.C. 20472

## LETTER OF MAP REVISION DETERMINATION DOCUMENT (CONTINUED)

#### **PUBLIC NOTIFICATION OF REVISION**

#### **PUBLIC NOTIFICATION**

FLOODING SOURCE	LOCATION OF REFERENCED ELEVATION	BFE (FEET NGVD)		MAP PANEL	
1 20051110 0001102		EFFECTIVE	REVISED	NUMBER(S)	
Stage Gulch Ditch	Approximately 150 feet downstream of Umatilla Street	589	585	410213 0001 C	
	Just downstream of South Edwards Road	598	596	410213 0001 C	

Within 90 days of the second publication in the local newspaper, any interested party may request that we reconsider this determination. Any request for reconsideration must be based on scientific or technical data. This revision is effective as of the date of this letter. However, until the 90-day period has elapsed, the revised BFEs presented in this LOMR may be changed.

A notice of changes will be published in the *Federal Register*. A short notice also will be published in your local newspaper on or about the dates listed below. Please refer to FEMA's website at https://www.floodmaps.fema.gov/fhm/Scripts/bfe\_main.asp for a more detailed description of proposed BFE changes, which will be posted approximately within a week of the date of this letter.

LOCAL NEWSPAPER Name: The East Oregonian

Dates: 08/28/2009 and 09/04/2009


This determination is based on the flood data presently available. The enclosed documents provide additional information regarding this determination. If you have any questions about this document, please contact the FEMA Map Assistance Center toll free at 1-877-336-2627 (1-877-FEMA MAP) or by letter addressed to the LOMC Clearinghouse, 6730 Santa Barbara Court, Elkridge, MD 21075. Additional Information about the NFIP is available on our website at http://www.fema.gov/nfip.

Siamak Esfandiary, Ph.D., P.E., CFM, Program Specialist Engineering Management Branch Mitigation Directorate

112553 10.3.1.09100493 102-D-A

	INCREASE	0.0 0.0 0.0 0.0 0.0 0.0 0.0 0.0 0.0 0.0			
	WITH FLOODWAY NGVD)	588.4 590.4 591.6 592.2 593.7 594.5	Confluence With Umatilla River  REFLECT LOMR  EFFECTIVE: August 17, 2009	DATA	Ŧ
	WITHOUT FLOODWAY (FEET	588.4 590.4 591.1 591.2 593.2 593.9 595.2		FLOODWAY D	STAGE GULCH
3	REGULATORY	588.4 590.4 591.1 591.6 593.2 593.9 595.2		OTJ	S
	MEAN VELOCITY (FEET PER SECOND)	6.0 7.8 7.0 7.0 7.0 7.8 7.8			
FLOODWAY	SECTION AREA (SQUARE FEET)	326 251 748 655 401 379 303 253			
FLOODING SOURCE	DISTANCE	3,373 4,023 4,428 5,193 5,833 6,683 8,328 8,328		EMERGENCY MANAGEMENT CITY OF STANFIELD, OR (UMATILLA CO.)	
	CROSS SECTION	Stage Gulch A B C C B H H	<sup>l</sup> Feet Above Conflue	FEDERAL EMERGENCY MANAGEMENT AGENCY	CITY OF STANFIEL (UMATILLA CO.)
				TAB	LE 2

ı

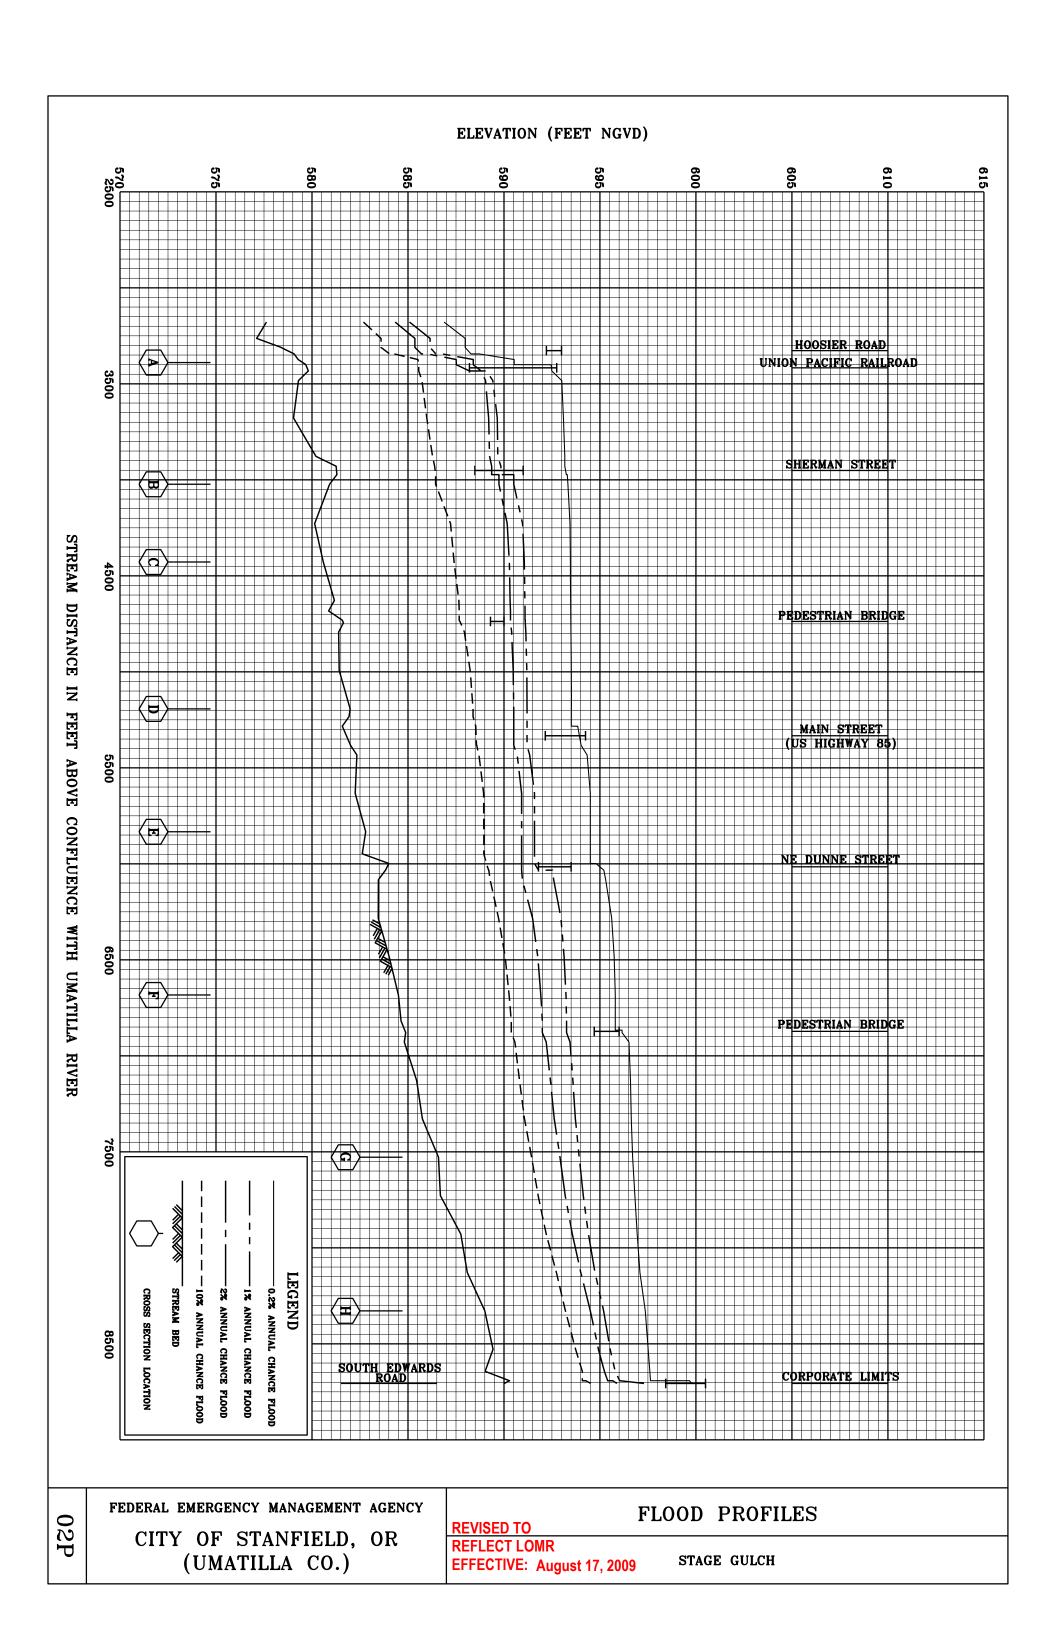

## NOTES TO USERS

This map is for use in administering the National Flood Insurance Program. I does not necessarily identify all areas subject to flooding, particularly from local drainage sources of small size. The **community map repository** should be consulted for possible updated or additional flood hazard information.

To obtain more detailed information in areas where Base FloodElevations (BFEs) and/or floodways have been determined, users are encouraged to consult the Flood Profiles, Floodway Data tables and/or Summary of Stillwater Elevations tables contained within the Flood Insurance Study (FIS) report that accompanies this FIRM. Users should be aware that BFEs shown on the FIRM represent rounded whole-foot elevations. These BFEs are intended for flood insurance rating purposes only and should not be used as the sole source of flood elevation information. Accordingly, flood elevation data presented in the FIS report should be utilized in conjunction with the FIRM for purposes of construction and/or floodplain management.

Coastal Base Flood Elevations (BFEs) shown on this map apply onlyandward of 0.0' North American Vertical Datum of 1988 (NAVD 88) Users of this FIRM should be aware that coastal flood elevations are also provided in the Summary of Stillwater Elevations tables in the Flood Insurance Study report for this jurisdiction. Elevations shown in the Summary of StillwaterElevations tables should be used for construction, and/or floodplain management purposes when they are higher than the elevations shown on this FIRM.

Boundaries of the floodways were computed at cross sections and interpolated between cross sections. The floodways were based on hydraulic considerations with regard to requirements of the National Flood Insurance Program. Floodway widths and other pertinent floodway data are provided in the Flood Insurance Study report for this jurisdiction.

Certain areas not in Special Flood Hazard Areas may be protected by flood control structures. Refer to Section 2.4 "Flood Protection Measures" of the Flood Insurance Study report for information on flood control structures in this jurisdiction

The projection used in the preparation of this map is UniversalTransverse Mercator (UTM) zone 12. The horizontal datum is NAD83, spheroid. Differences in datum, spheroid, projection or UTM zones used in the production of FIRMs for adjacent jurisdictions may result in slight positiona differences in map features across jurisdiction boundaries. These differences do not affect the accuracy of the FIRM.

Flood elevations on this map are referenced to the North American Vertical Datum of 1988. These flood elevations must be compared to structuated ground elevations referenced to the same vertical datum. For information regarding conversion between the National Geodetic Vertical Datum of 1929 and the North American Vertical Datum of 1988, visit the National Geodetic Survey website at www.ngs.noaa.gov or contact the National Geodetic Survey at the following address:

NGS Information Services NOAA, N/NGS12

National Geodetic Survey SSMC-3, #9202

1315 East-West Highway Silver Spring, Maryland 20910-3282 (301) 713-3242

To obtain current elevation, description, and/or location information forbench marks shown on this map, please contact the Information Services Branch tbe National Geodetic Survey at (301) 713-3242, or visit their website at http://www.ngs.noaa.gov.

Base map information shown on this FIRM was provided in digital format by U.S Farm Service National Agriculture Imagery Program (NAIP), dated summer 2004, and by the U.S. Geological Survey Digital Orthophoto Quadrangles, dated 1993 and later, produced at a scale of 1:24000. The data was obtained from the Geographic Reference Center (AGRC).

Based on updated topographic information, this map reflects more detailed and up-to-date stream channel configurations and floodplain delineations than those shown on the previous FIRM for this jurisdiction. As a result, the Flood Profiles and Floodway Data tables may reflect stream channel distances that differ from what is shown on the map. Also, the road to floodplain relationships for unrevised streams may differ from what is shown on previous maps.

Corporate limits shown on this map are based on the best data available at the time of publication. Because changes due to annexations or de-annexations may have occurred after this map was published, map users should


Please refer to the separately printed **Map Index** for an overview map of the county showing the layout of map panels; community map repositor addresses; and a Listing of Communities table containing National Flood Insurance Program dates for each community as well as a listing of the panels on which each community is located.

Contact the FEMA Map Service Center at 1-800-358-9616 for information on available products associated with this FIRM. Available products may include previously issued Letters of Map Change, a Flood Insurance Study report, and/or digital versions of this map. The FEMA Map Service Center may also be, reached by Fax at 1-800-358-9620 and its website at http://msc.fema.gov/.

If you have **questions about this map**or questions concerning the National Flood Insurance Program in general, please call **1-877-FEMA MAP**(1-877-336-2627) or visit the FEMA website at www.fema.gov/business/nfip/.

Accredited Levee Notes to Users: Check with your local community to obtain more information, such as the estimated level of protection provided (which may exceed the 1-percent-annual-chance level) and Emergency Action Plan, on the levee system(s) shown as providing protection for areas on this panel. To mitigate flood risk is residual risk areas, property owners and residents are encouraged to consider flood insurance and floodproofing or other protective measures.

For more information on flood insurance, interested parties should visit the FEMA Website at http://fema.gov/business/nfip/index.shtm

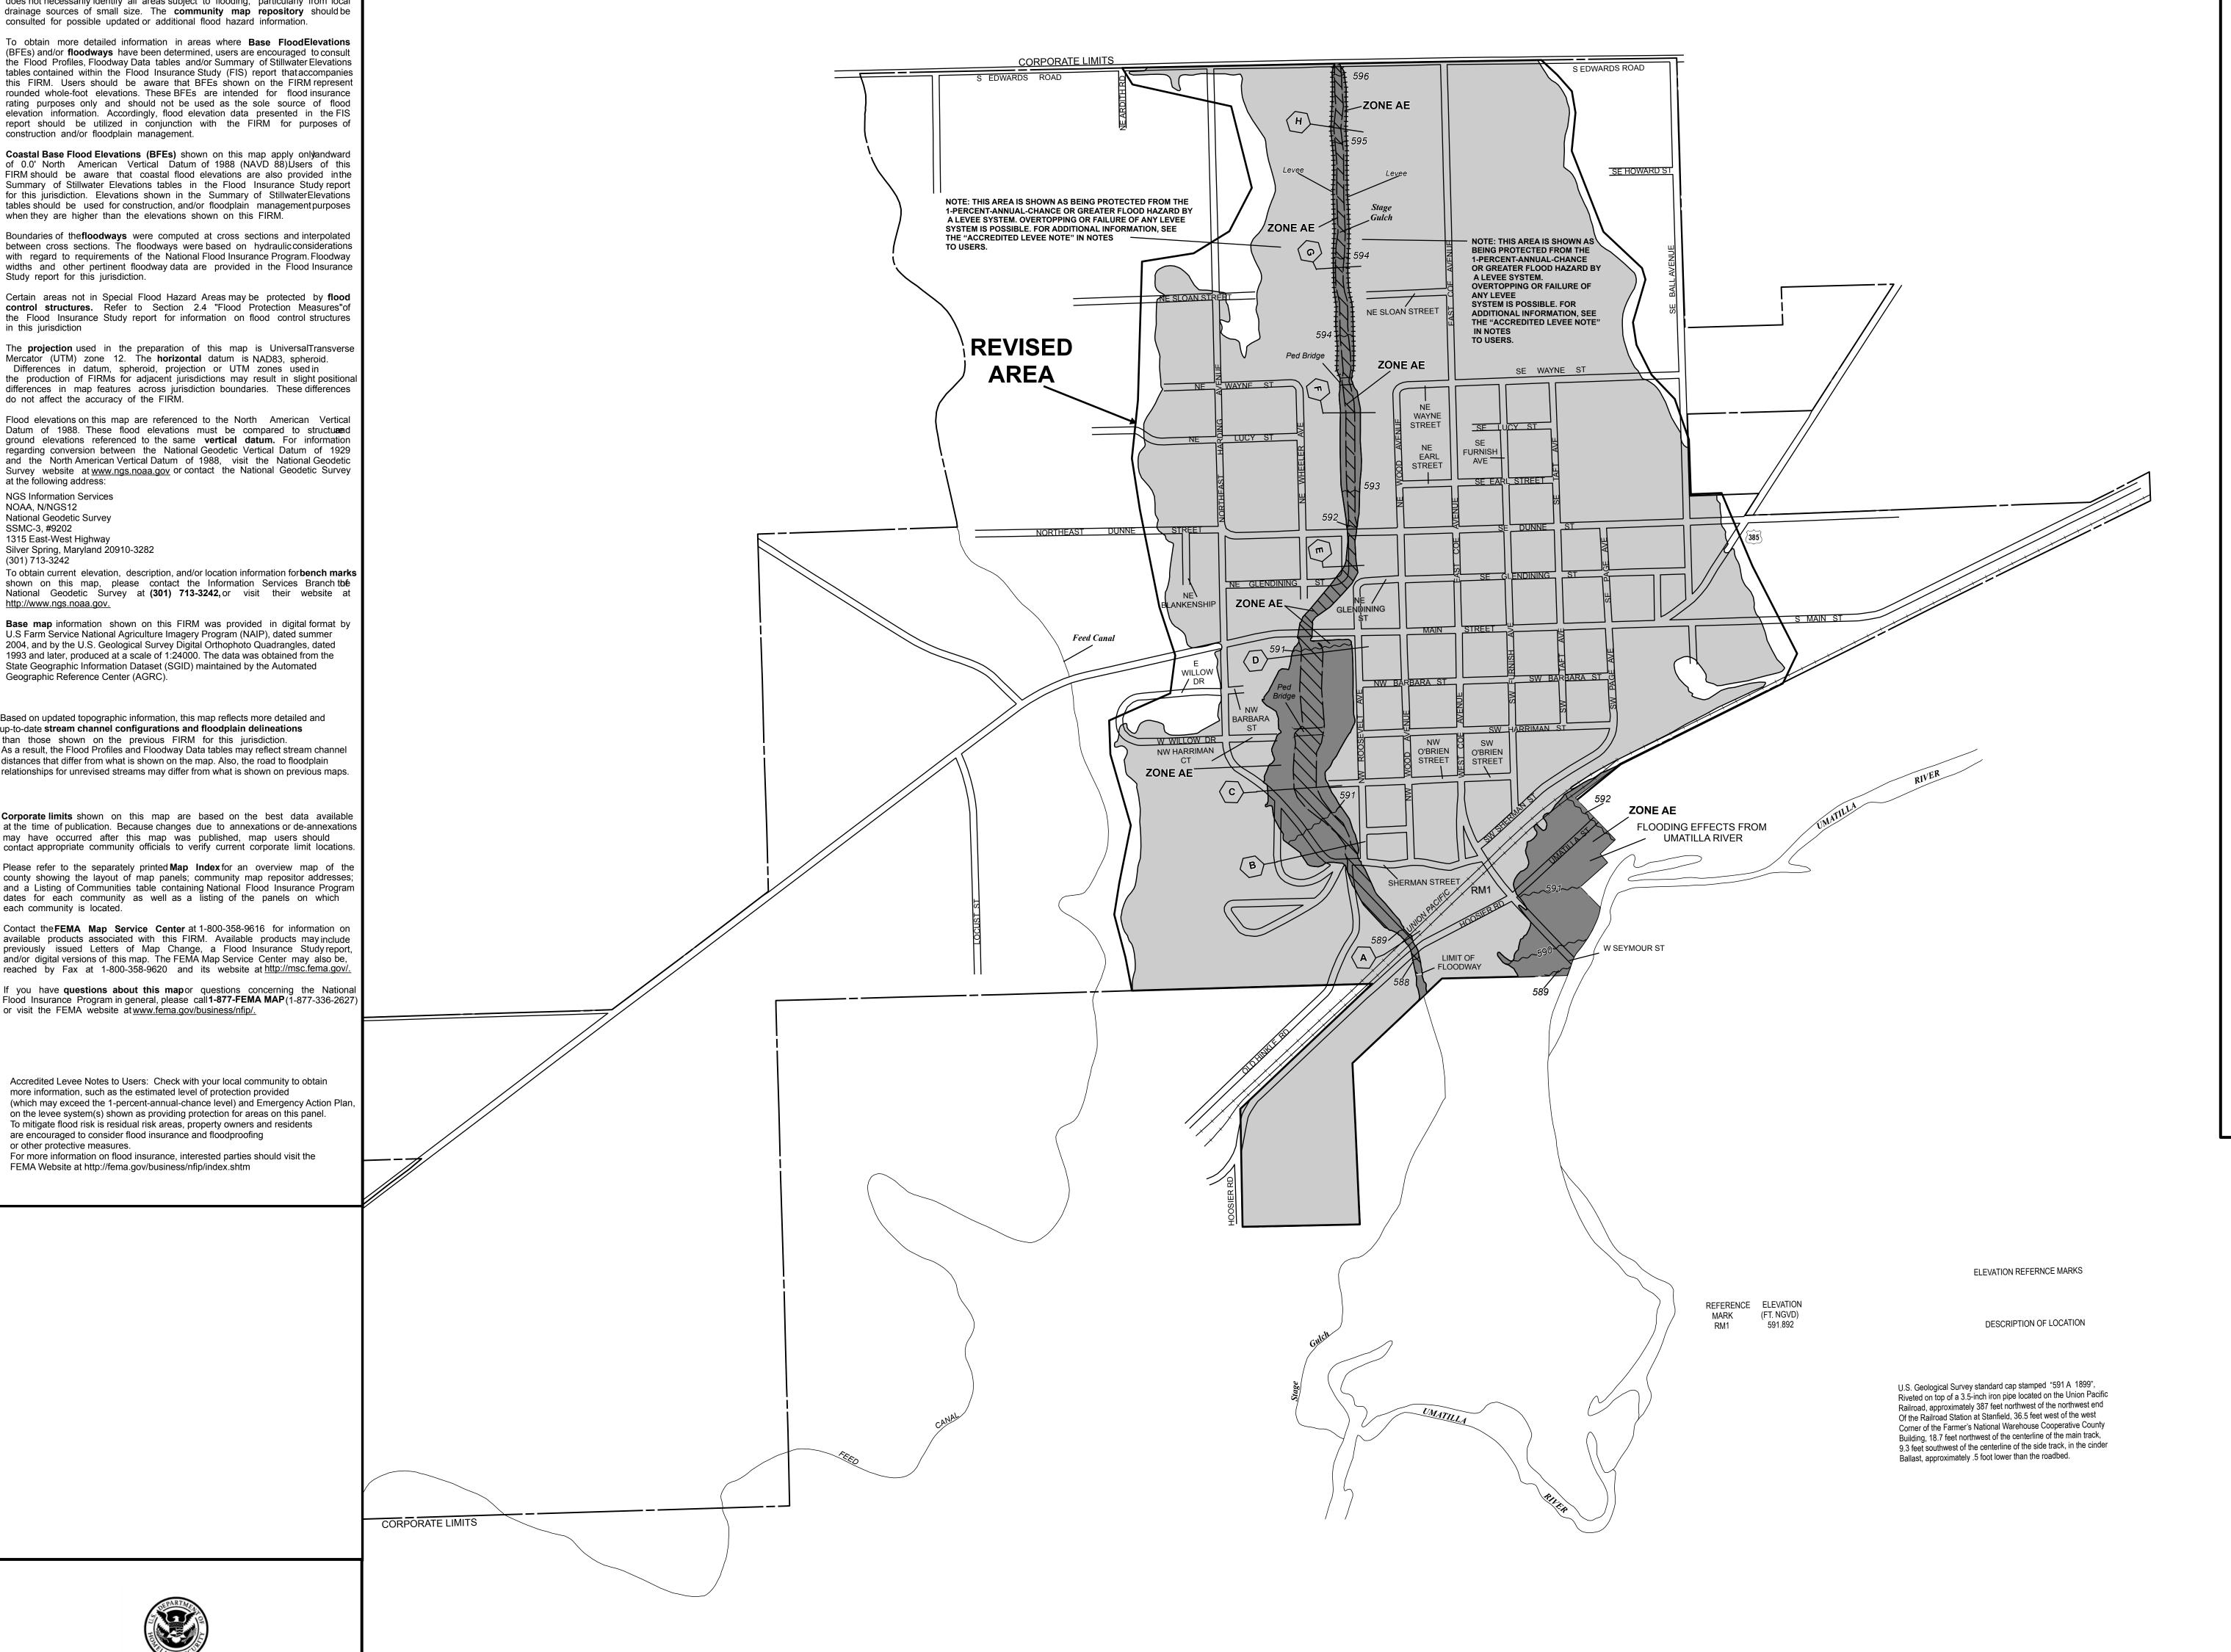

**LEGEND** SPECIAL FLOOD HAZARD AREAS (SFHAs) SUBJECT TO INUNDATION BY THE 1% ANNUAL CHANCE FLOOD The 1% annual chance flood (100-year flood), also known as the base flood, is the flood that has a 1% chance of being equaled or exceeded in any given year. The Special Flood Hazard Area is the area subject to flooding by the 1% annual chance flood. Areas of Special Flood Hazard include Zones A, AE, AH, AO, AR, A99, V and VE. The Base Flood Elevation is the water surface elevation of the 1% annual chance flood. **ZONE A** No base flood elevation determined. ZONE AE Flood depths of 1 to 3 feet (usually areas of ponding); base flood Flood depths of 1 to 3 feet (usually sheet flow on sloping terrain); average depths determined. For areas of alluvial fan flooding, velocities Area of special flood hazard formerly protected from the 1% annual decertified. Zone AR indicates that the former flood control system is being restored to provide protection from the 1% annual chance of greater flood event. Areas to be protected from 1% annual chance flood event by a Federal flood protection system under construction; no base flood elevations Coastal flood zone with velocity hazard (wave action); no base flood Coastal flood zone with velocity hazard (wave action); base flood elevations FLOODWAY AREAS IN ZONE AE The floodway is the channel of a stream plus any adjacent floodplain areas that must be kept free of encroachment so that the 1% annual chance flood can be carried without substantial increases in flood heights. OTHER FLOOD AREAS Areas of 0.2% annual chance flood; areas of 1% annual chance flood with average depths of less than 1 foot or with drainage areas less than 1 square mile; and areas protected by levees from 1% annual chance OTHER AREAS Areas determined to be outside the 0.2% annual chance floodplain. Areas in which flood hazards are undetermined, but possible. COASTAL BARRIER RESOURCES SYSTEM (CBRS) AREAS OTHERWISE PROTECTED AREAS (OPAs) CBRS areas and OPAs are normally located within or adjacent to Special Flood Hazard Areas. ——— 1% annual chance floodplain boundary ———— 0.2% annual chance floodplain boundary ——— Floodway boundary **–** — Zone D boundary •••••••••••••••• CBRS and OPA boundary ← Boundary dividing Special Flood Hazard Areas of different Base Flood Elevations, flood depths or flood velocities. Base Flood Elevations line and value; elevation in feet\* Base Flood Elevation value where uniform within zone; \* Referenced to the North American Vertical Datum of 1988 (NAVD 88) **A** Cross Section line Geographic coordinates referenced to the North American 97°07'30", 32°22'30" Datum of 1983 (NAD 83) 1000-meter Universal Transverse Mercator grid values, zone 12

> For community map revision history prior to countywide mapping, refer to the Community Map History table located in the Flood Insurance Study report for this jurisdiction. To determine if flood insurance is available in this community, contact your insurance agent or call the National Flood Insurance Program at 1-800-638-6620.

MAP REPOSITORY Refer to listing of Map Repositories on Map Index

EFFECTIVE DATE OF COUNTYWIDE

FLOOD INSURANCE RATE MAP DATE: April, 2 2009

EFFECTIVE DATE(S) OF REVISION(S) TO THIS PANEL

this FIRM panel)

6000000 FT

5000-foot grid ticks: New York State Plane coordinate

system, east zone (FIPSZONE 3101), Transverse Mercator

Bench mark (see explanation in Notes to Users section of



**MAP SCALE 1" = 400** 

400 0 NATIONAL FLOOD INSURANCE PROGRAM **FIRM FLOOD INSURANCE RATE MAP** CITY OF STANFIELD, **OREGON** UMATILLA COUNTY **ONLY PANEL PRINTED REVISED TO** REFLECT LOMR EFFECTIVE: August 17, 2009 COMMUNITY-PANEL NUMBER 410213 000 1 C **MAP REVISED: SEPTEMBER 4, 1986** 



**Federal Emergency Management Agency**