


1N R 30  
1N R 31

784250

NZ-3P-128

8-19-56

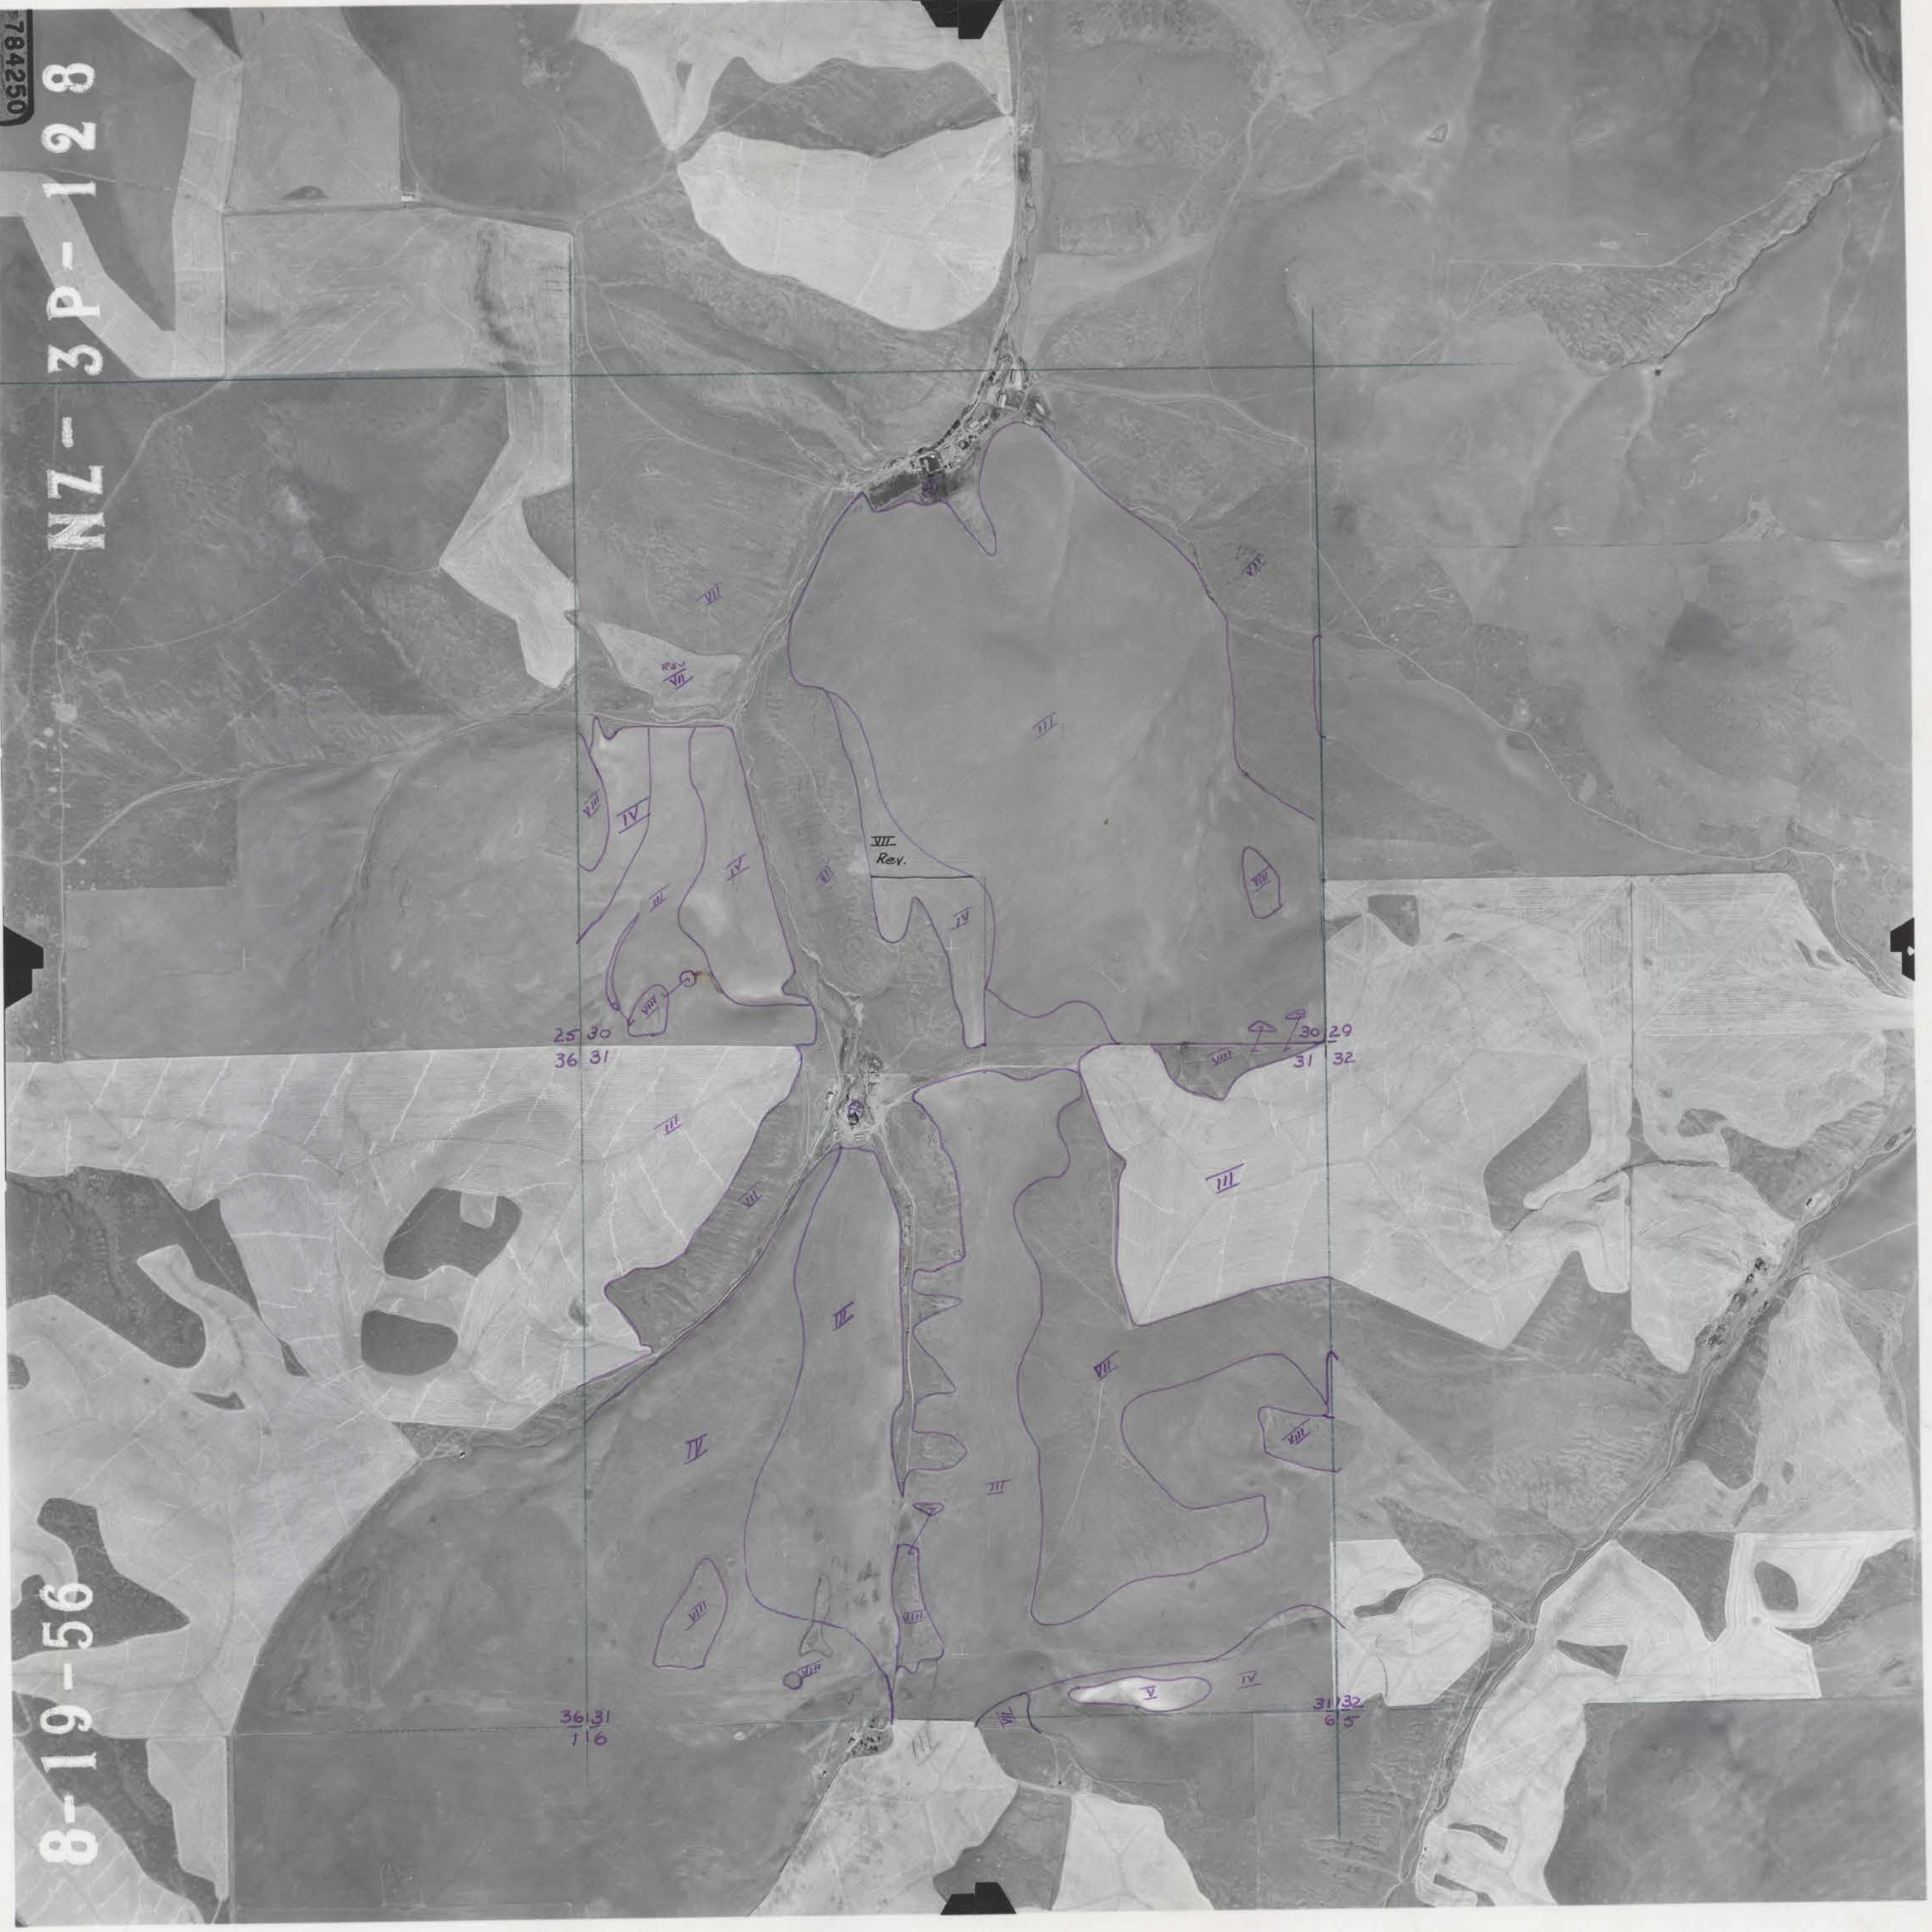

25 30  
36 31

30 29  
31 32

36 31  
116

31 32  
65

VII  
Rev.