


NZ-7P-116

8-31-56

15 31

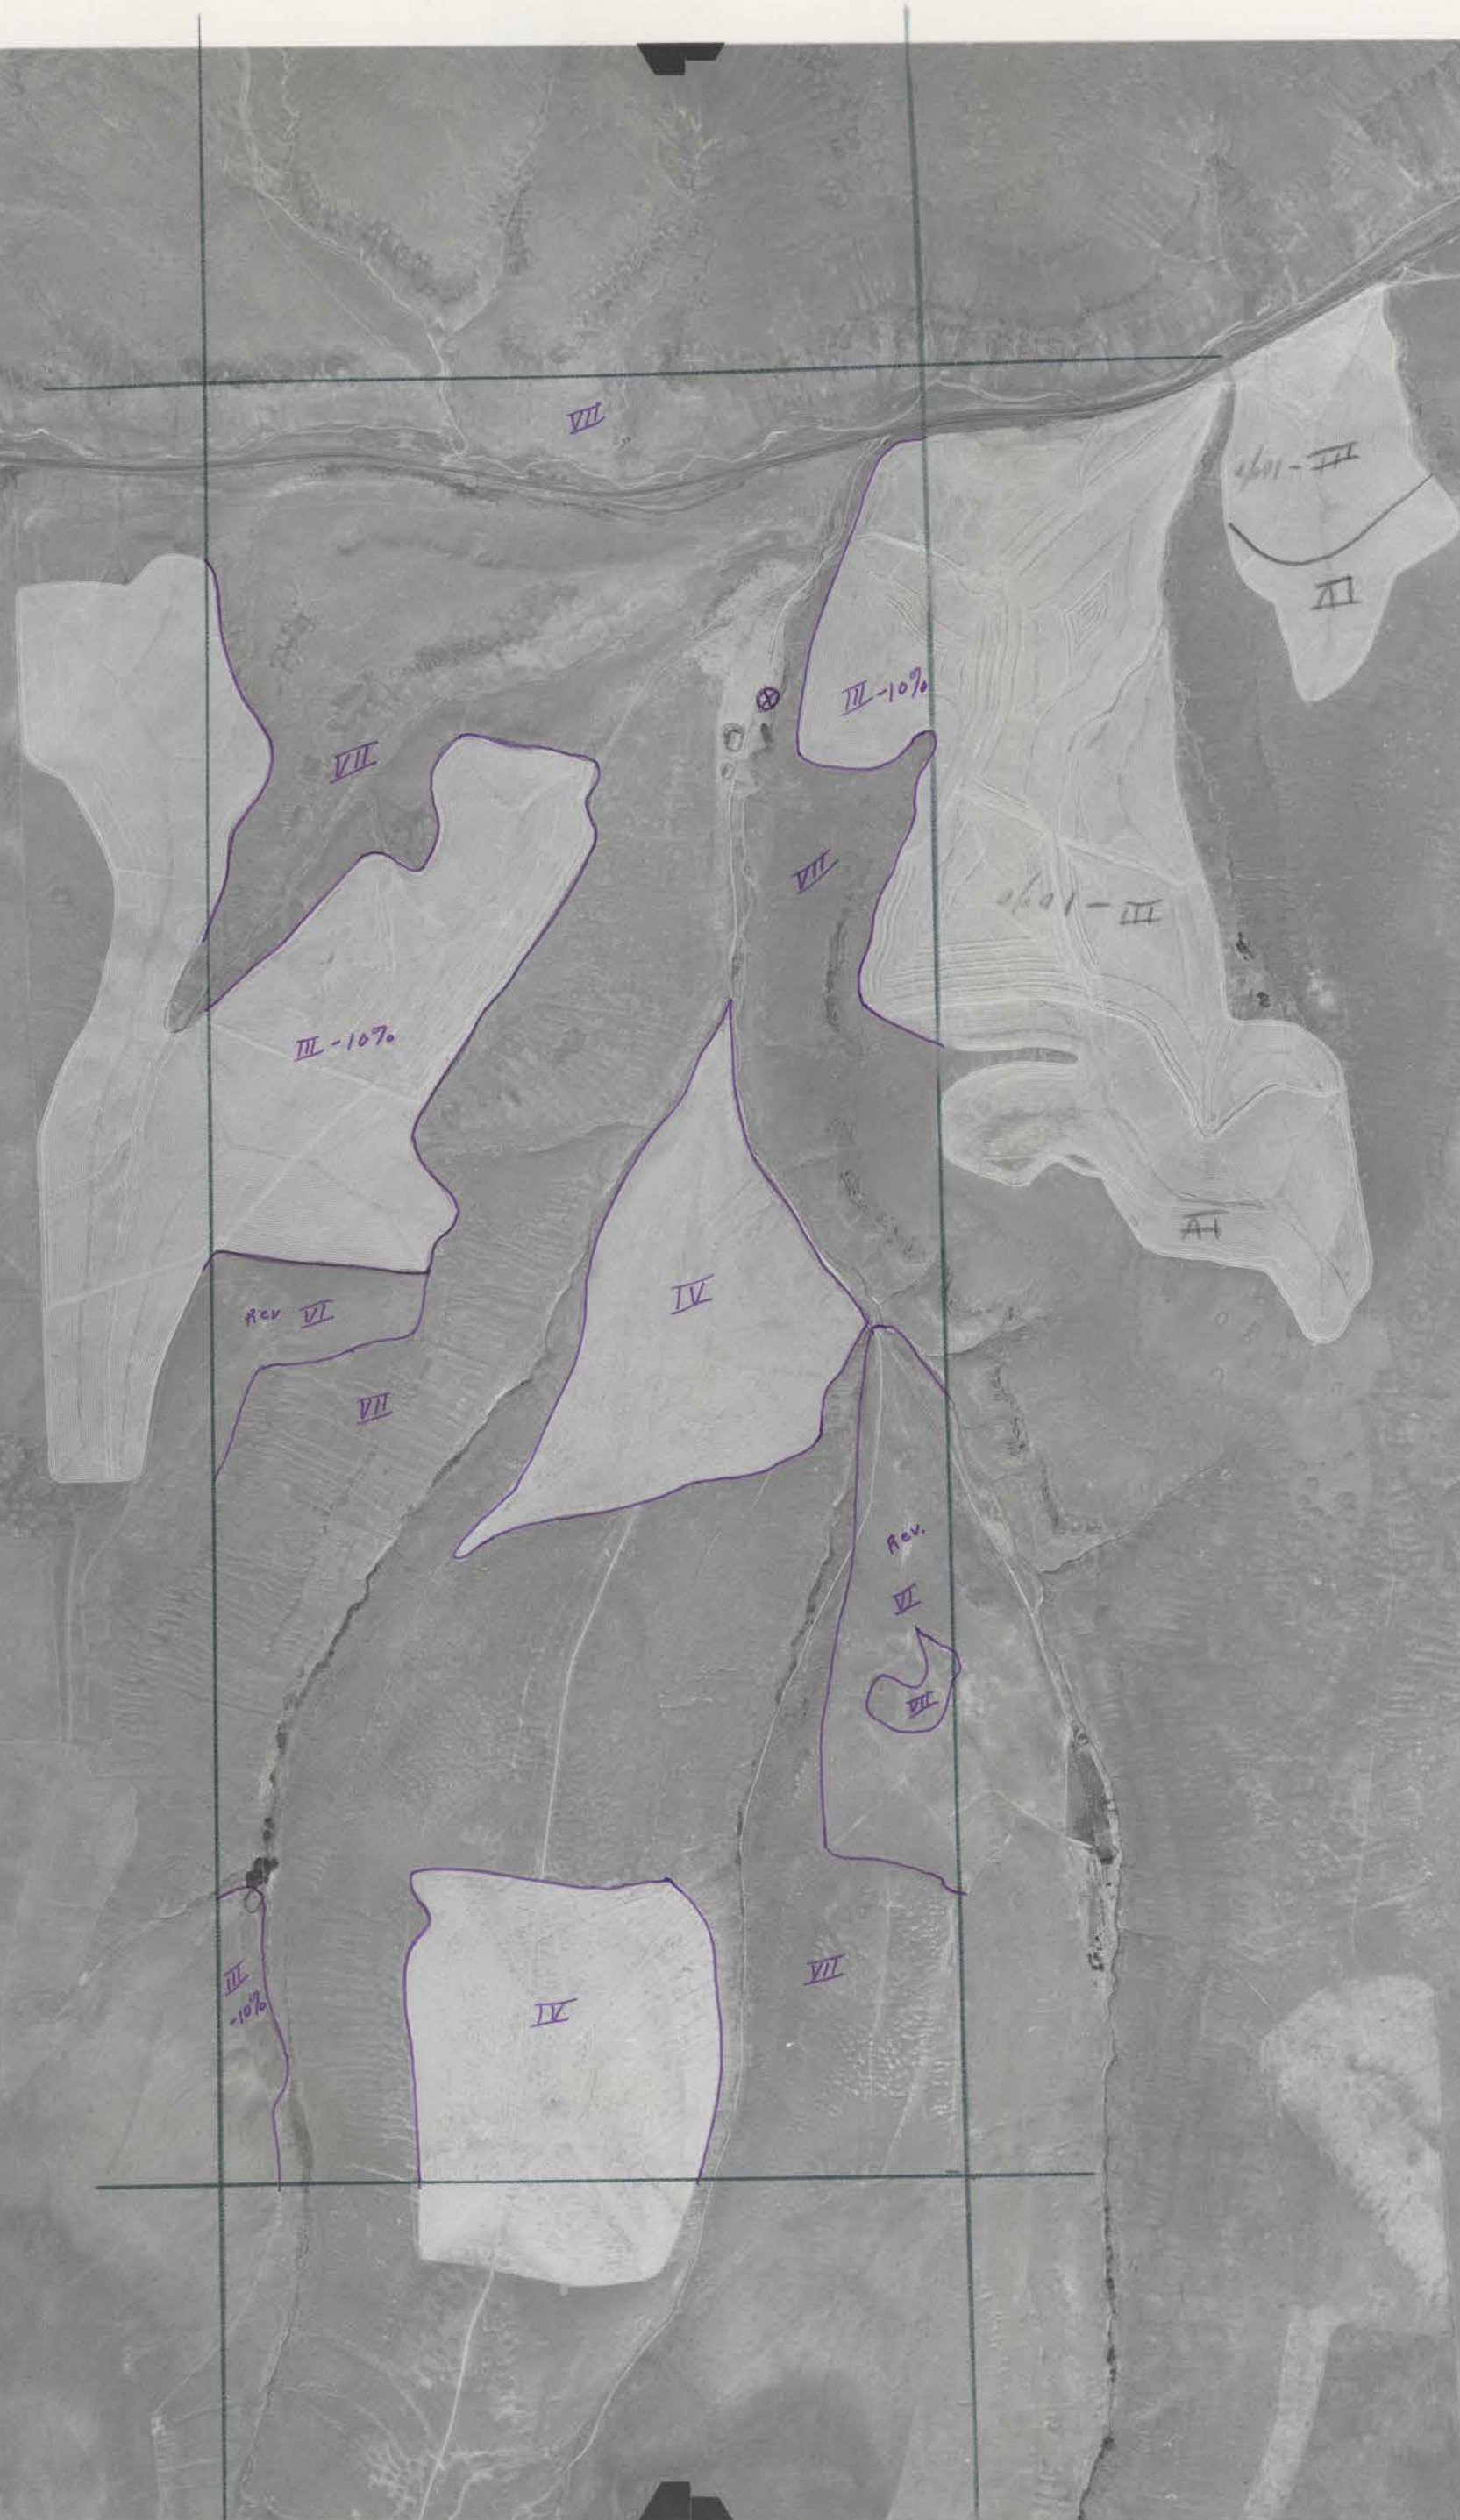

784250