


7-22-61

UM 6-10

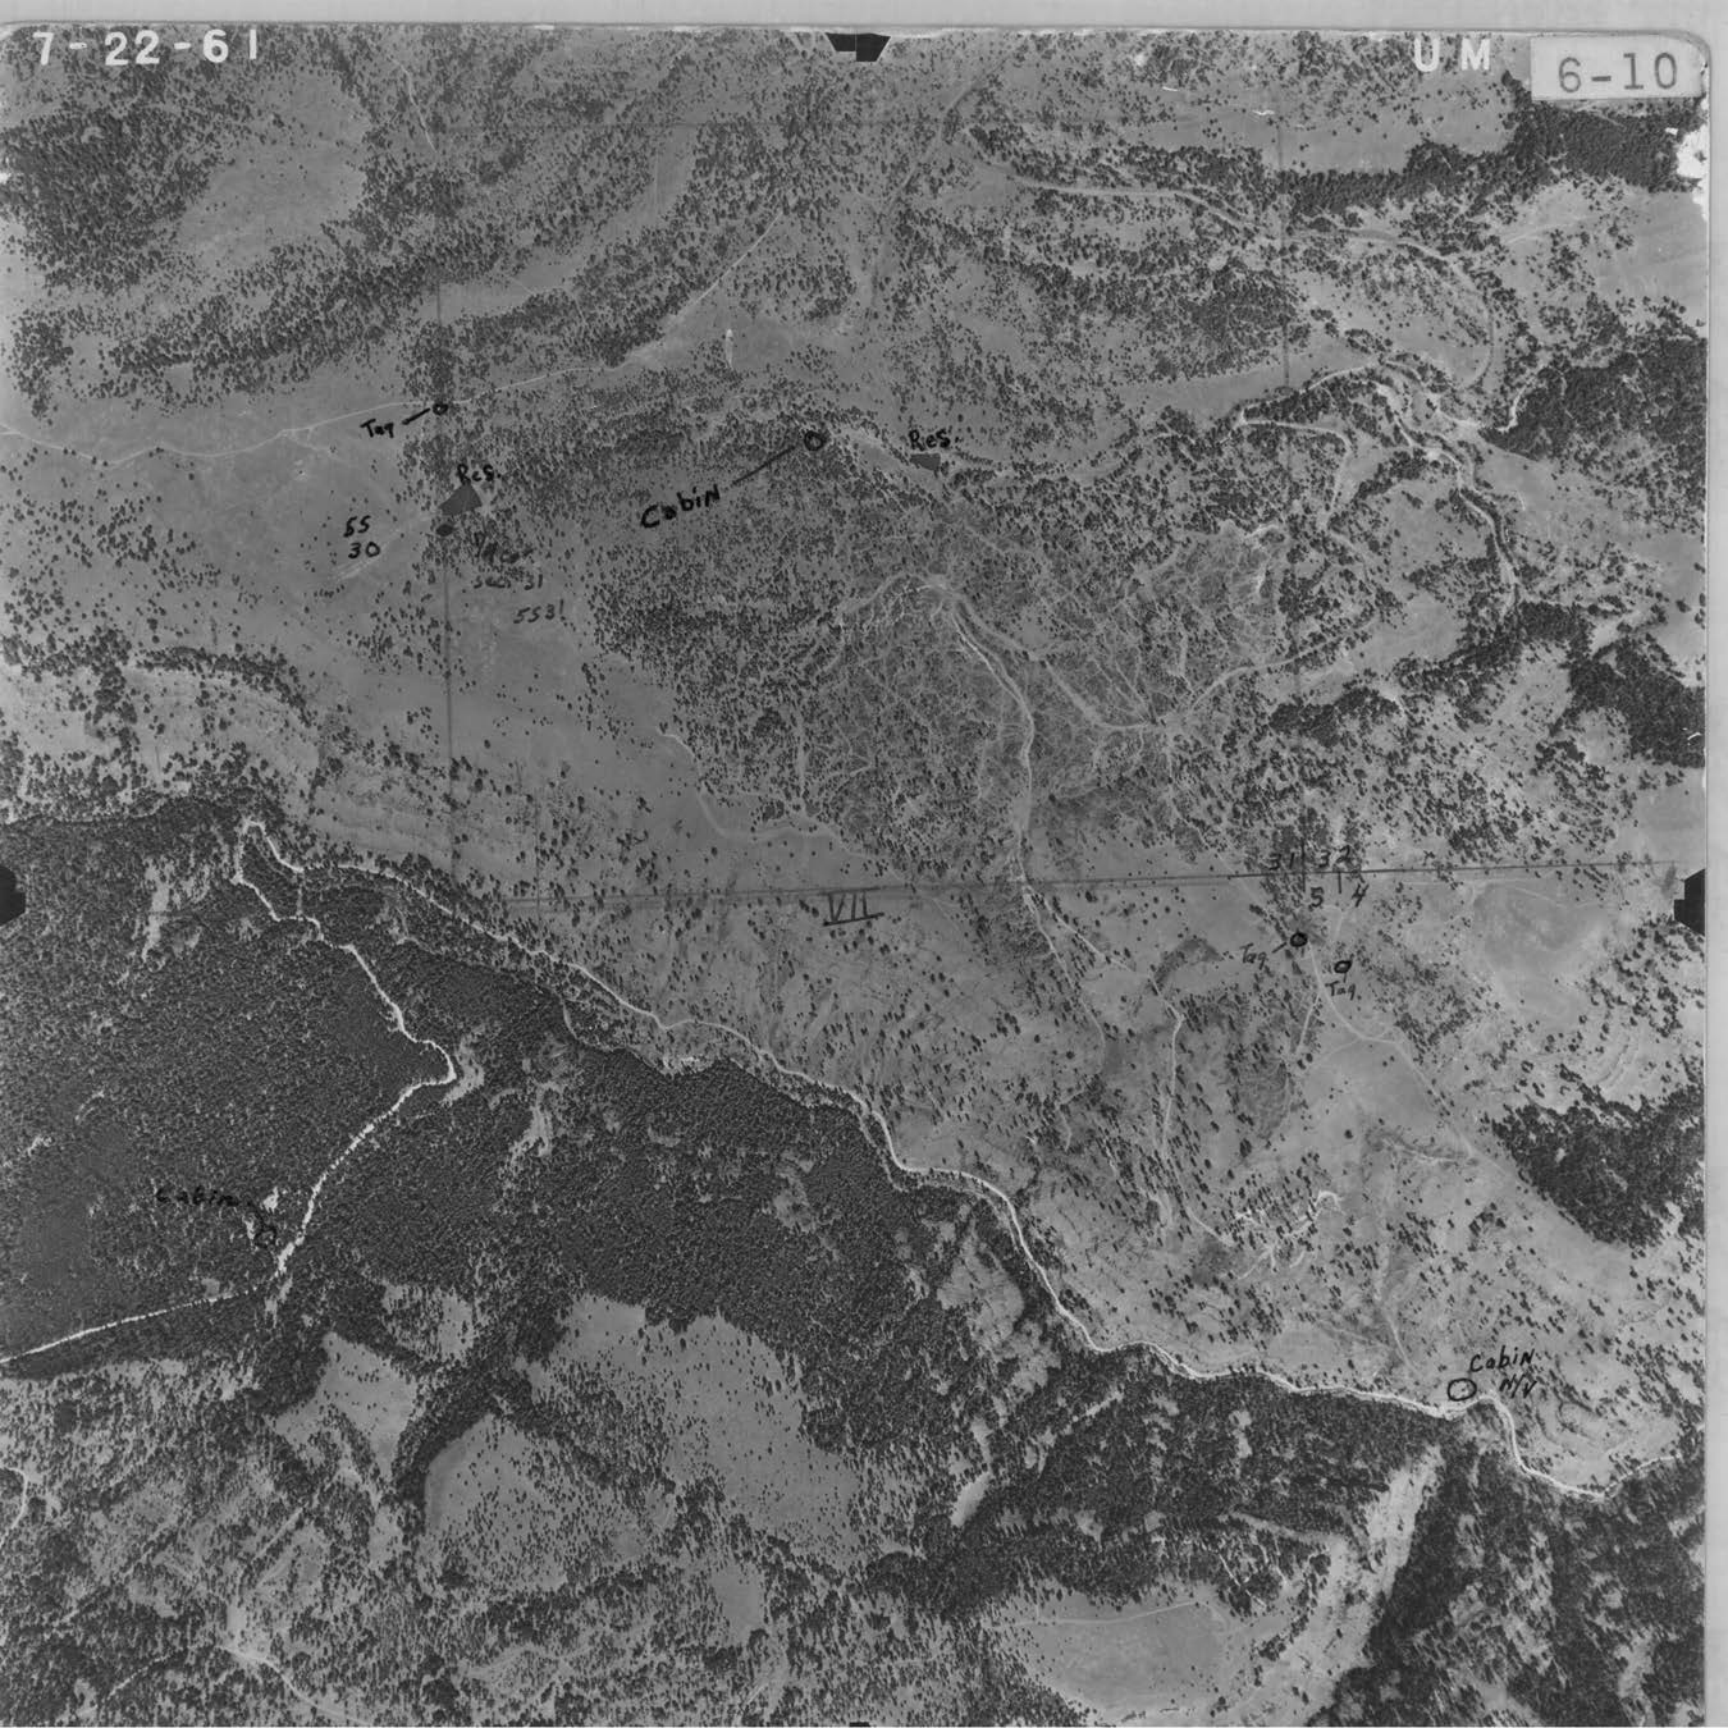

Tay

Res.

Cabin

Res.

55
30

553!

VII

31 32

5 4

Tay

Tay

Cabin
MV