

T4N-R32E

G15

166
170


1M205
1M204

R

212

41059-378

55

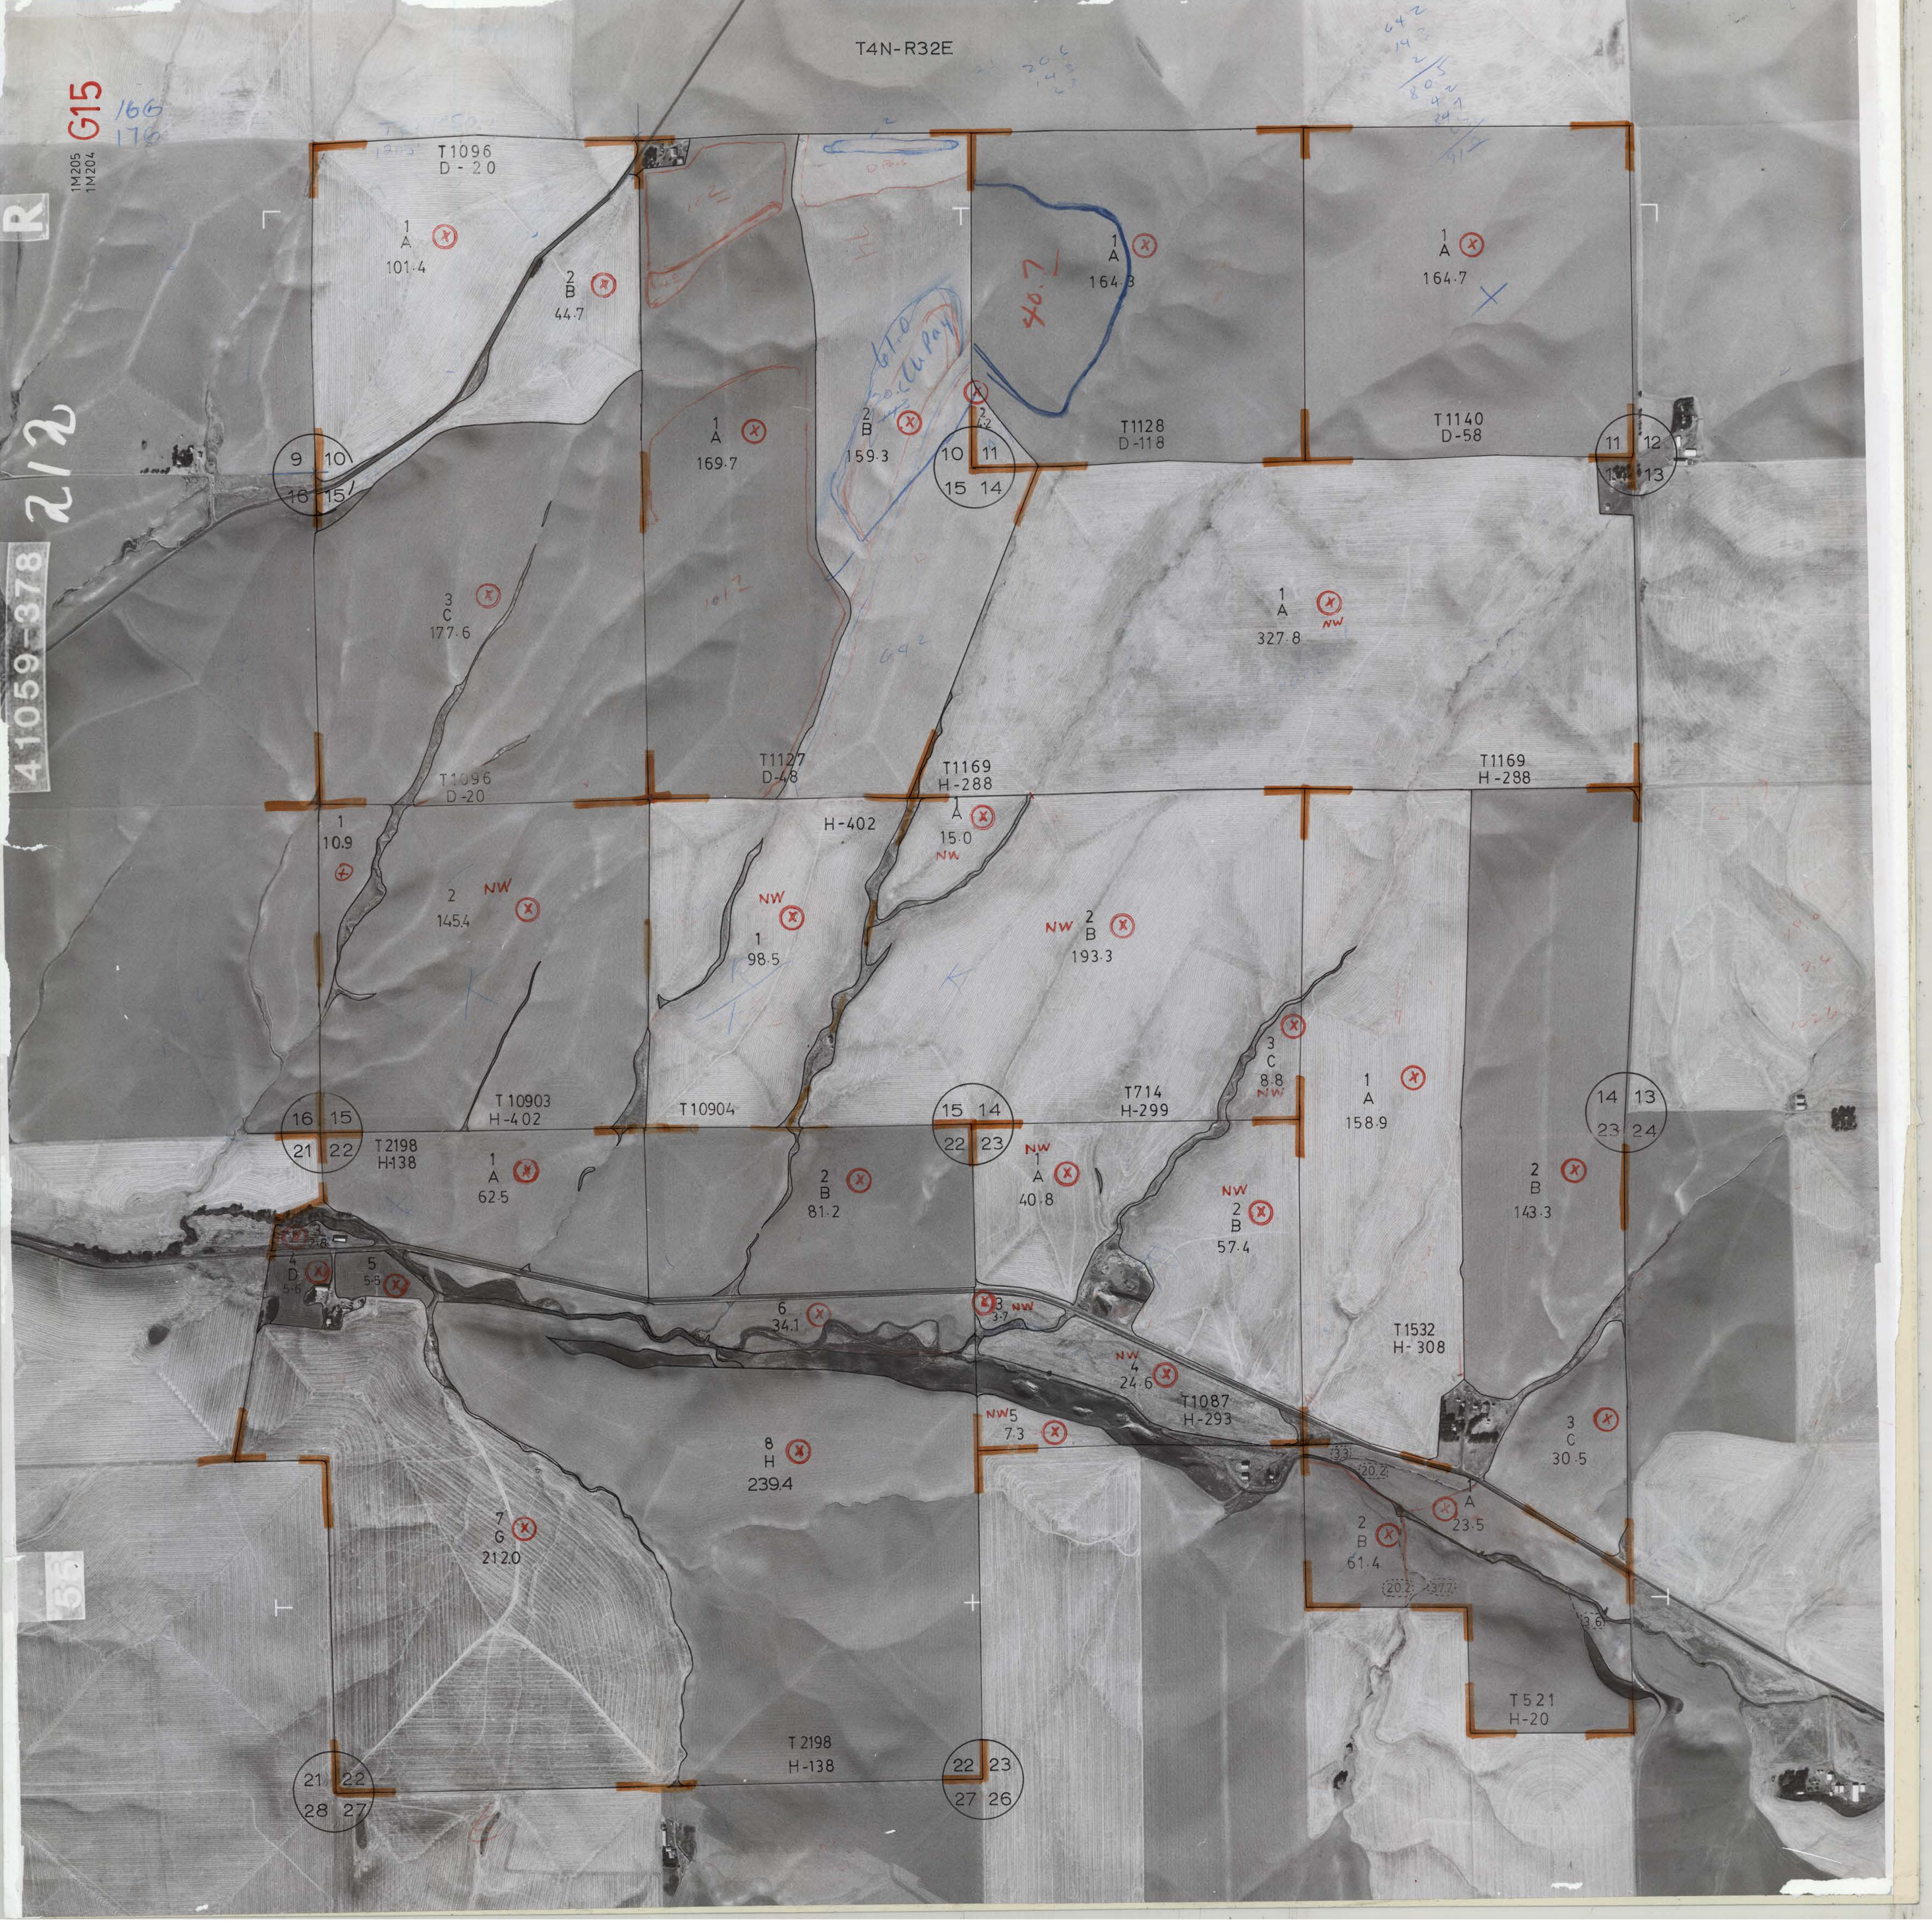

9 10
16 15

10 11
15 14

11 12
14 13

16 15
21 22

15 14
22 23

14 13
23 24

21 22
28 27

22 23
27 26

T1096
D-20

T1128
D-118

T1140
D-58

T1096
D-20

T1127
D-48

T1169
H-288

T1169
H-288

T10903
H-402

T10904

T714
H-299

T2198
H138

T1532
H-308

T1087
H-293

T521
H-20

7
6
212.0

8
H
239.4

2
B
61.4

3
C
30.5

2
B
143.3

NW
2
B
57.4

NW
1
A
40.8

NW
1
98.5

NW
2
B
193.3

2
NW
145.4

3
C
177.6

1
A
327.8

1
A
169.7

2
B
159.3

1
A
164.3

1
A
164.7

1
A
101.4

2
B
44.7

40.7

642
142
205
241
412

20
205
241

101.2

642

19.0
3.4
102.6