


55 HIGH ELEVATION P11 H 4M 66 122 122

LH1

22

41059-378

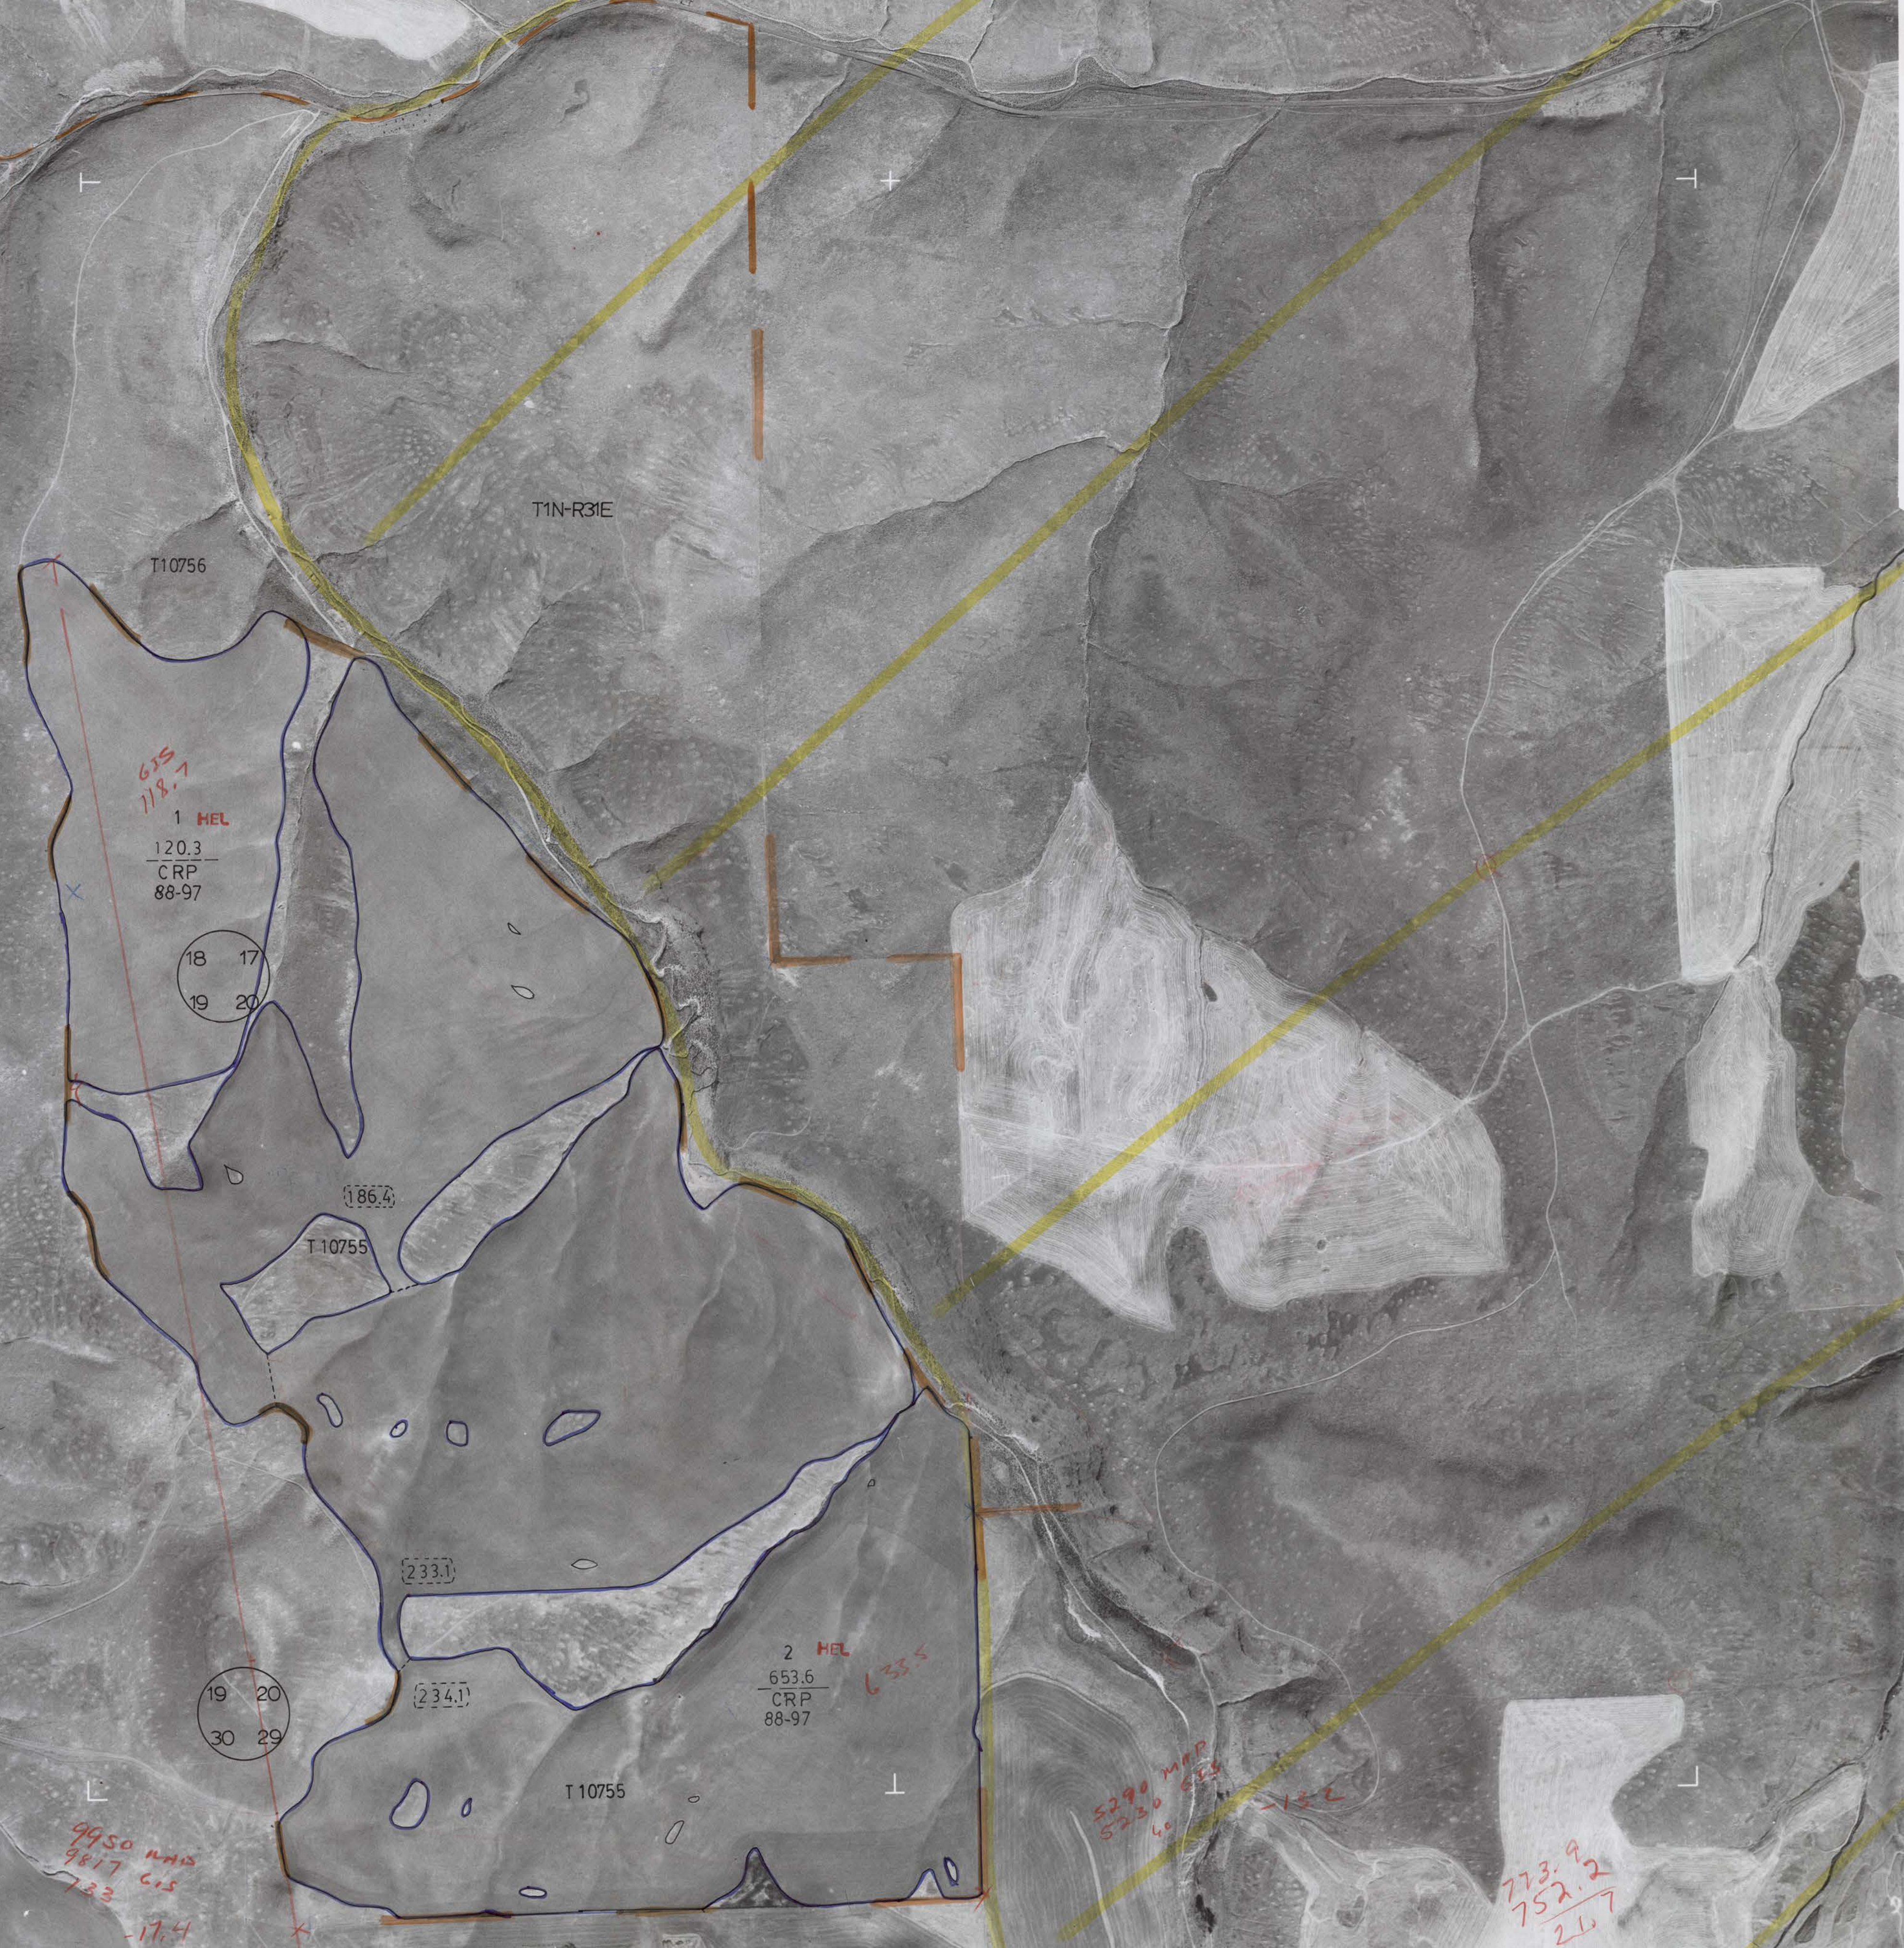

GIS
118.1
1 HEL

120.3
CRP
88-97

18	17
19	20

186.4

T10755

233.1

234.1

2 HEL
653.6
CRP
88-97

633.5

9950 NAD
9817 GIS
733
-17.4

19	20
30	29

5290 MAP
5230 GIS
40

773.9
752.2
21.7