


CHAINED SCALE  
3521

48 B I'

T2S-R31E

14W-1

U 12

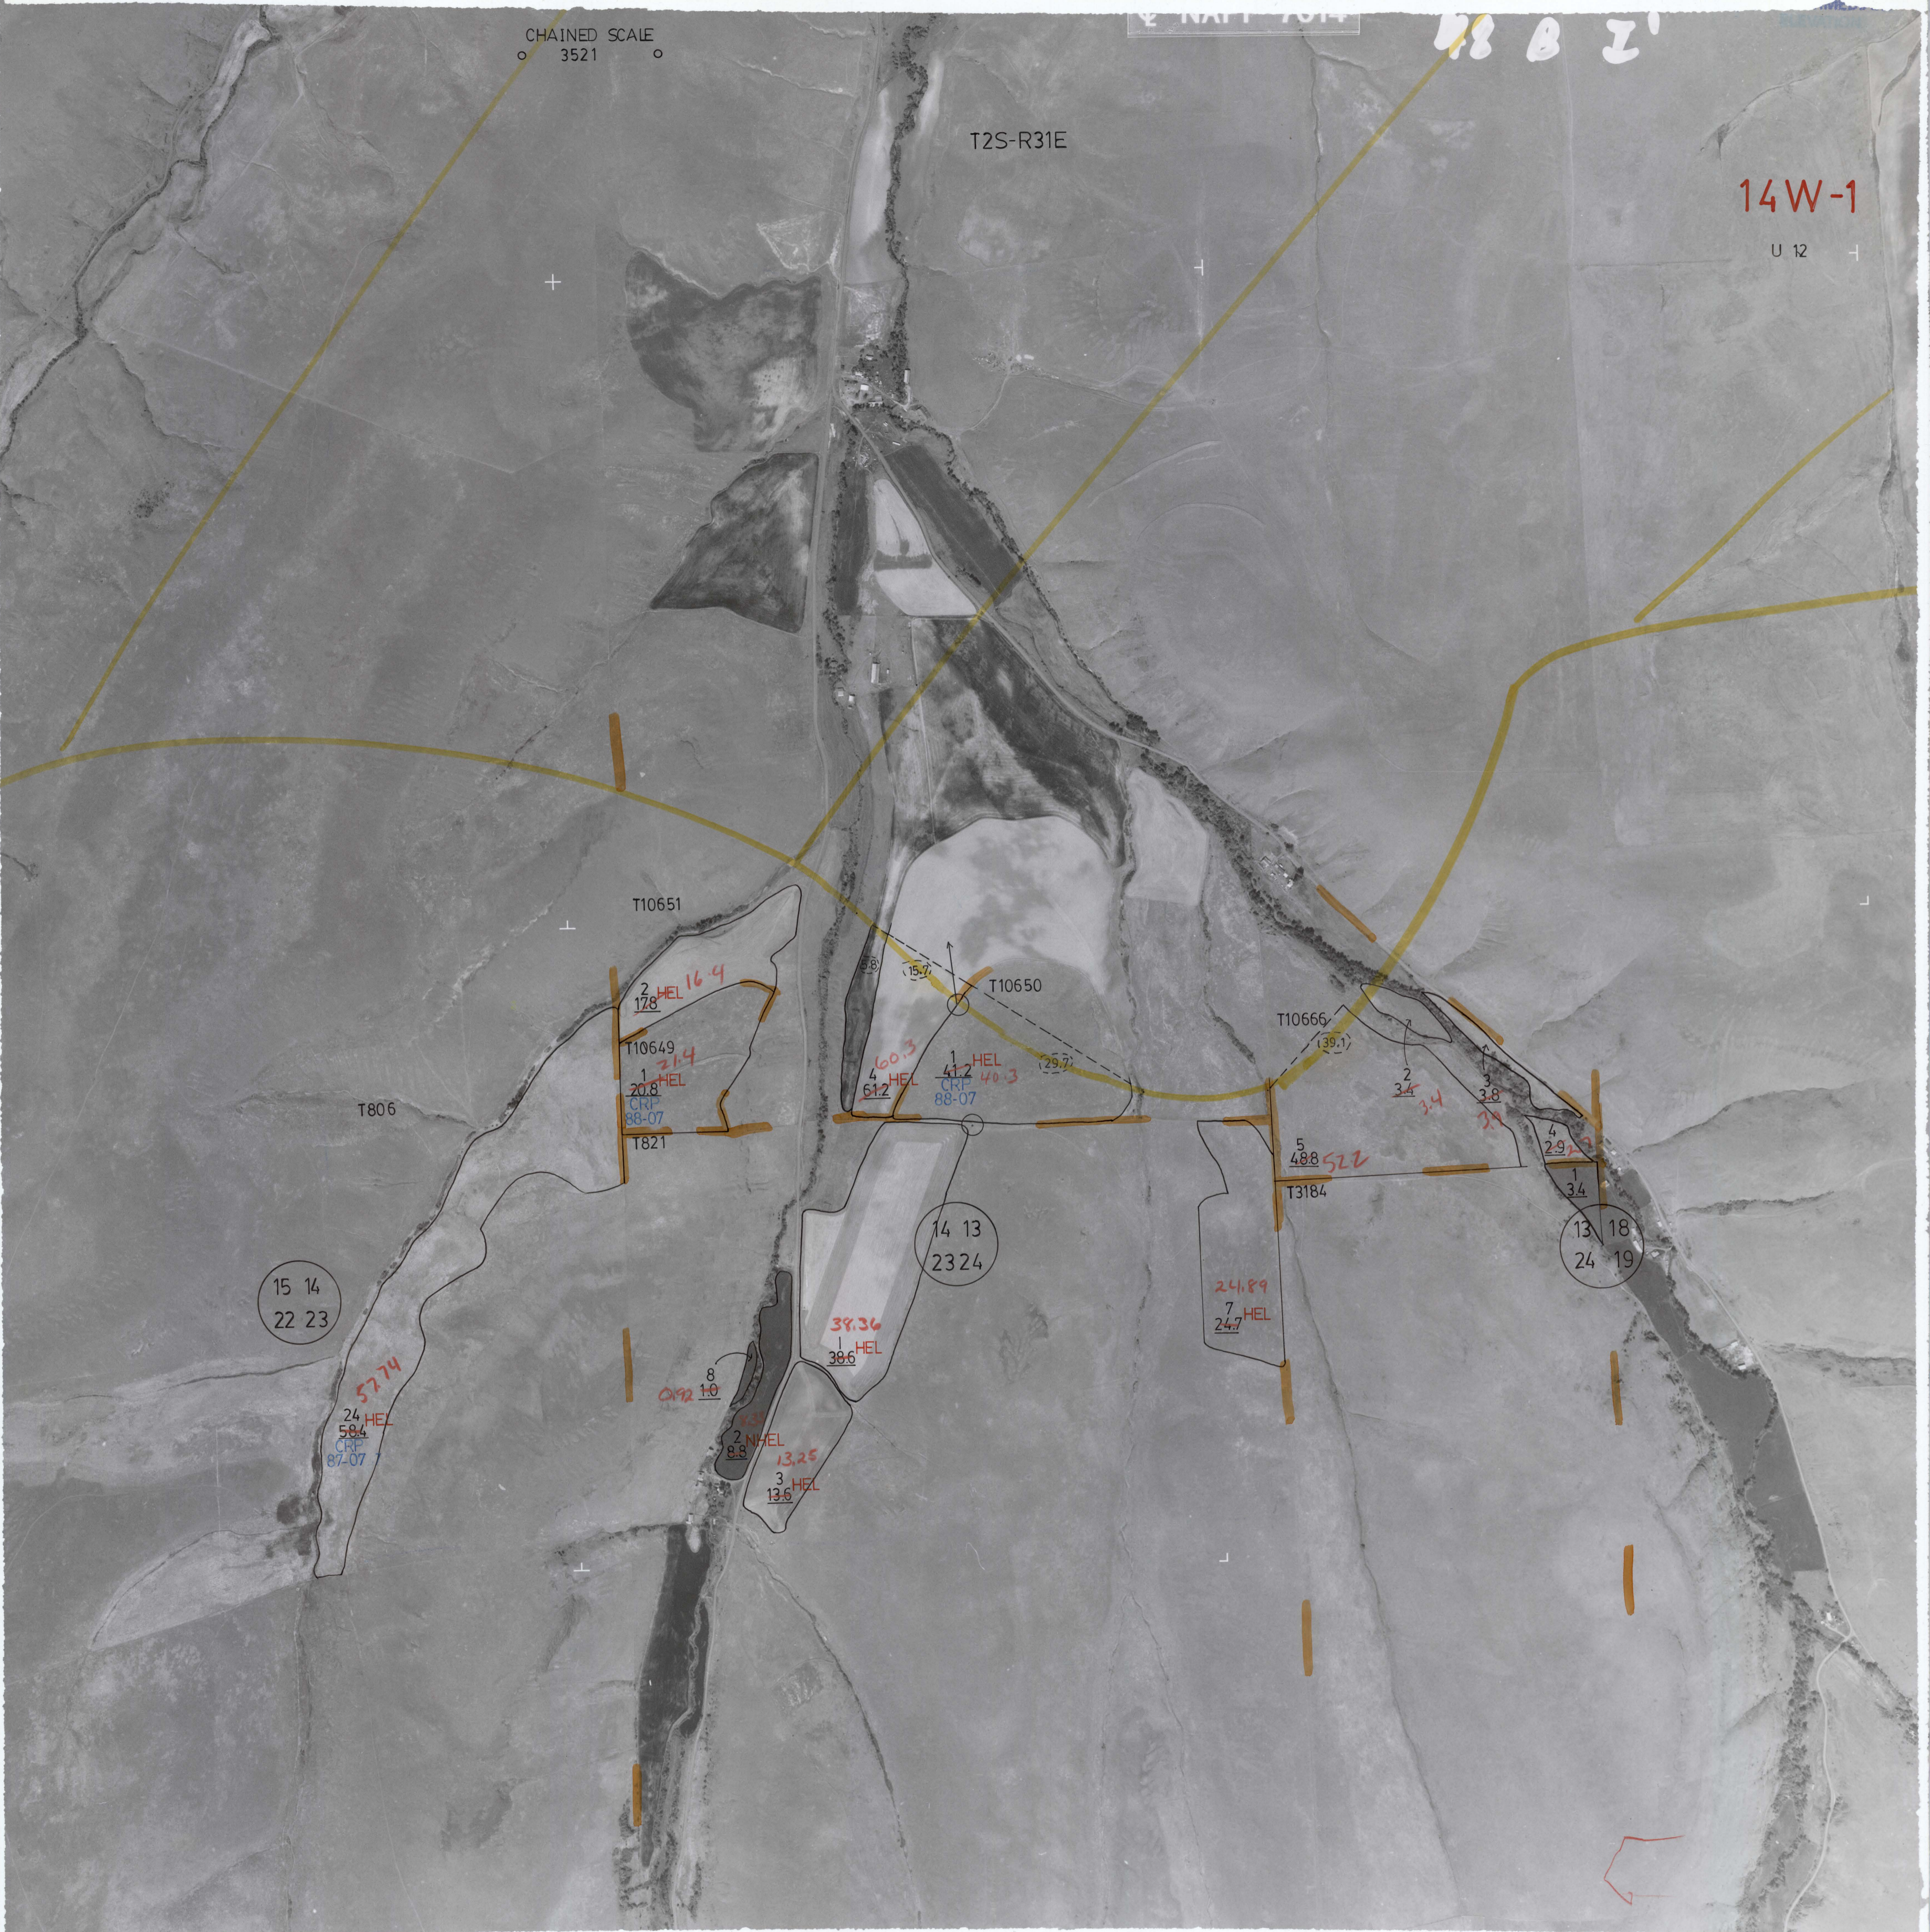

15 14  
22 23

14 13  
23 24

13 18  
24 19

T10651

T10650

T10666

T806

T10649  
T821

T3184

24 HEL  
58.4  
CRP  
87-07

2 HEL  
178  
16.4

4 HEL  
61.2  
60.3  
1 HEL  
41.2  
CRP  
88-07  
40.3

5  
48.8  
52.2

2  
3.4  
3.4

3  
3.8  
3.8

4  
2.9  
2.9

1  
3.4

24.89  
7  
24.7  
HEL

8  
0.92  
1.0

38.36  
38.6  
HEL

2 HEL  
8.8  
13.25  
3  
13.6  
HEL