

NAPP-7035

56 EC

15 GG


EE 14

T3211

9 10
16 15

10 11
15 14

T5S-R32E

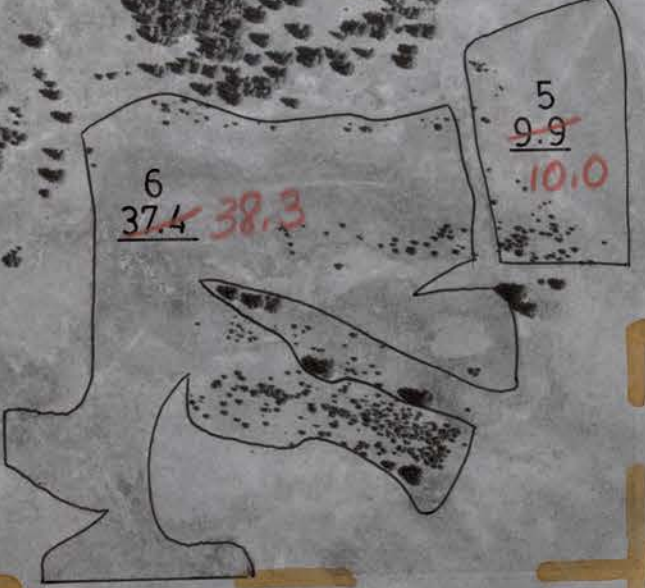

T9668

T9667

T 11852

16 15
21 22

15 14
22 23

T 11851

