

☪ NAPP-7014

37 EL Hi


15 M-1

M 13

T2N-R32E

SEE MAP
15 M-2

T 11291

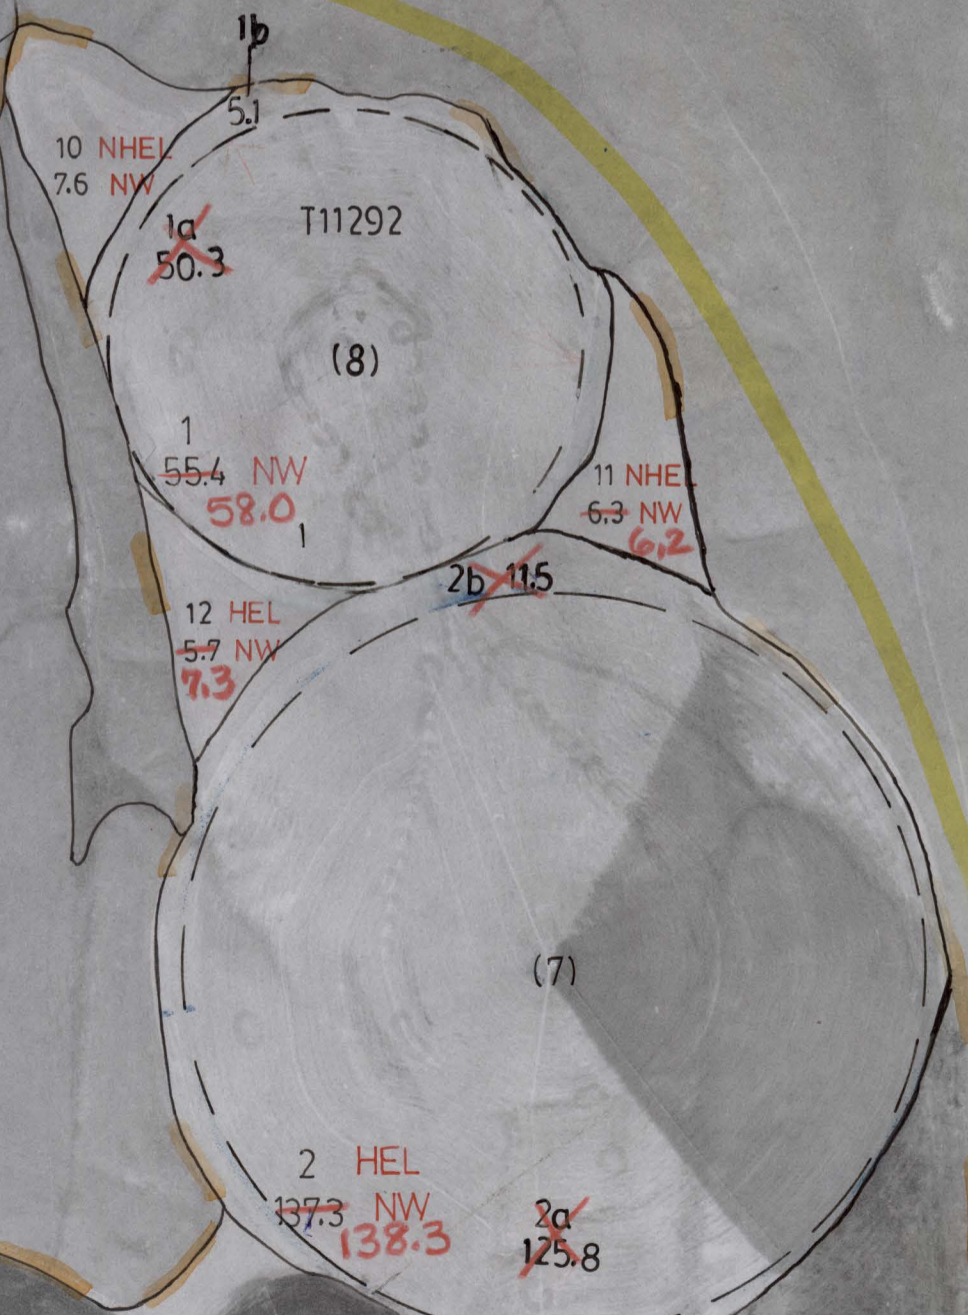

2 HEL
377.1 NW
CRP 89-98

168.3

18 17
19 20

SEE MAP
15 N