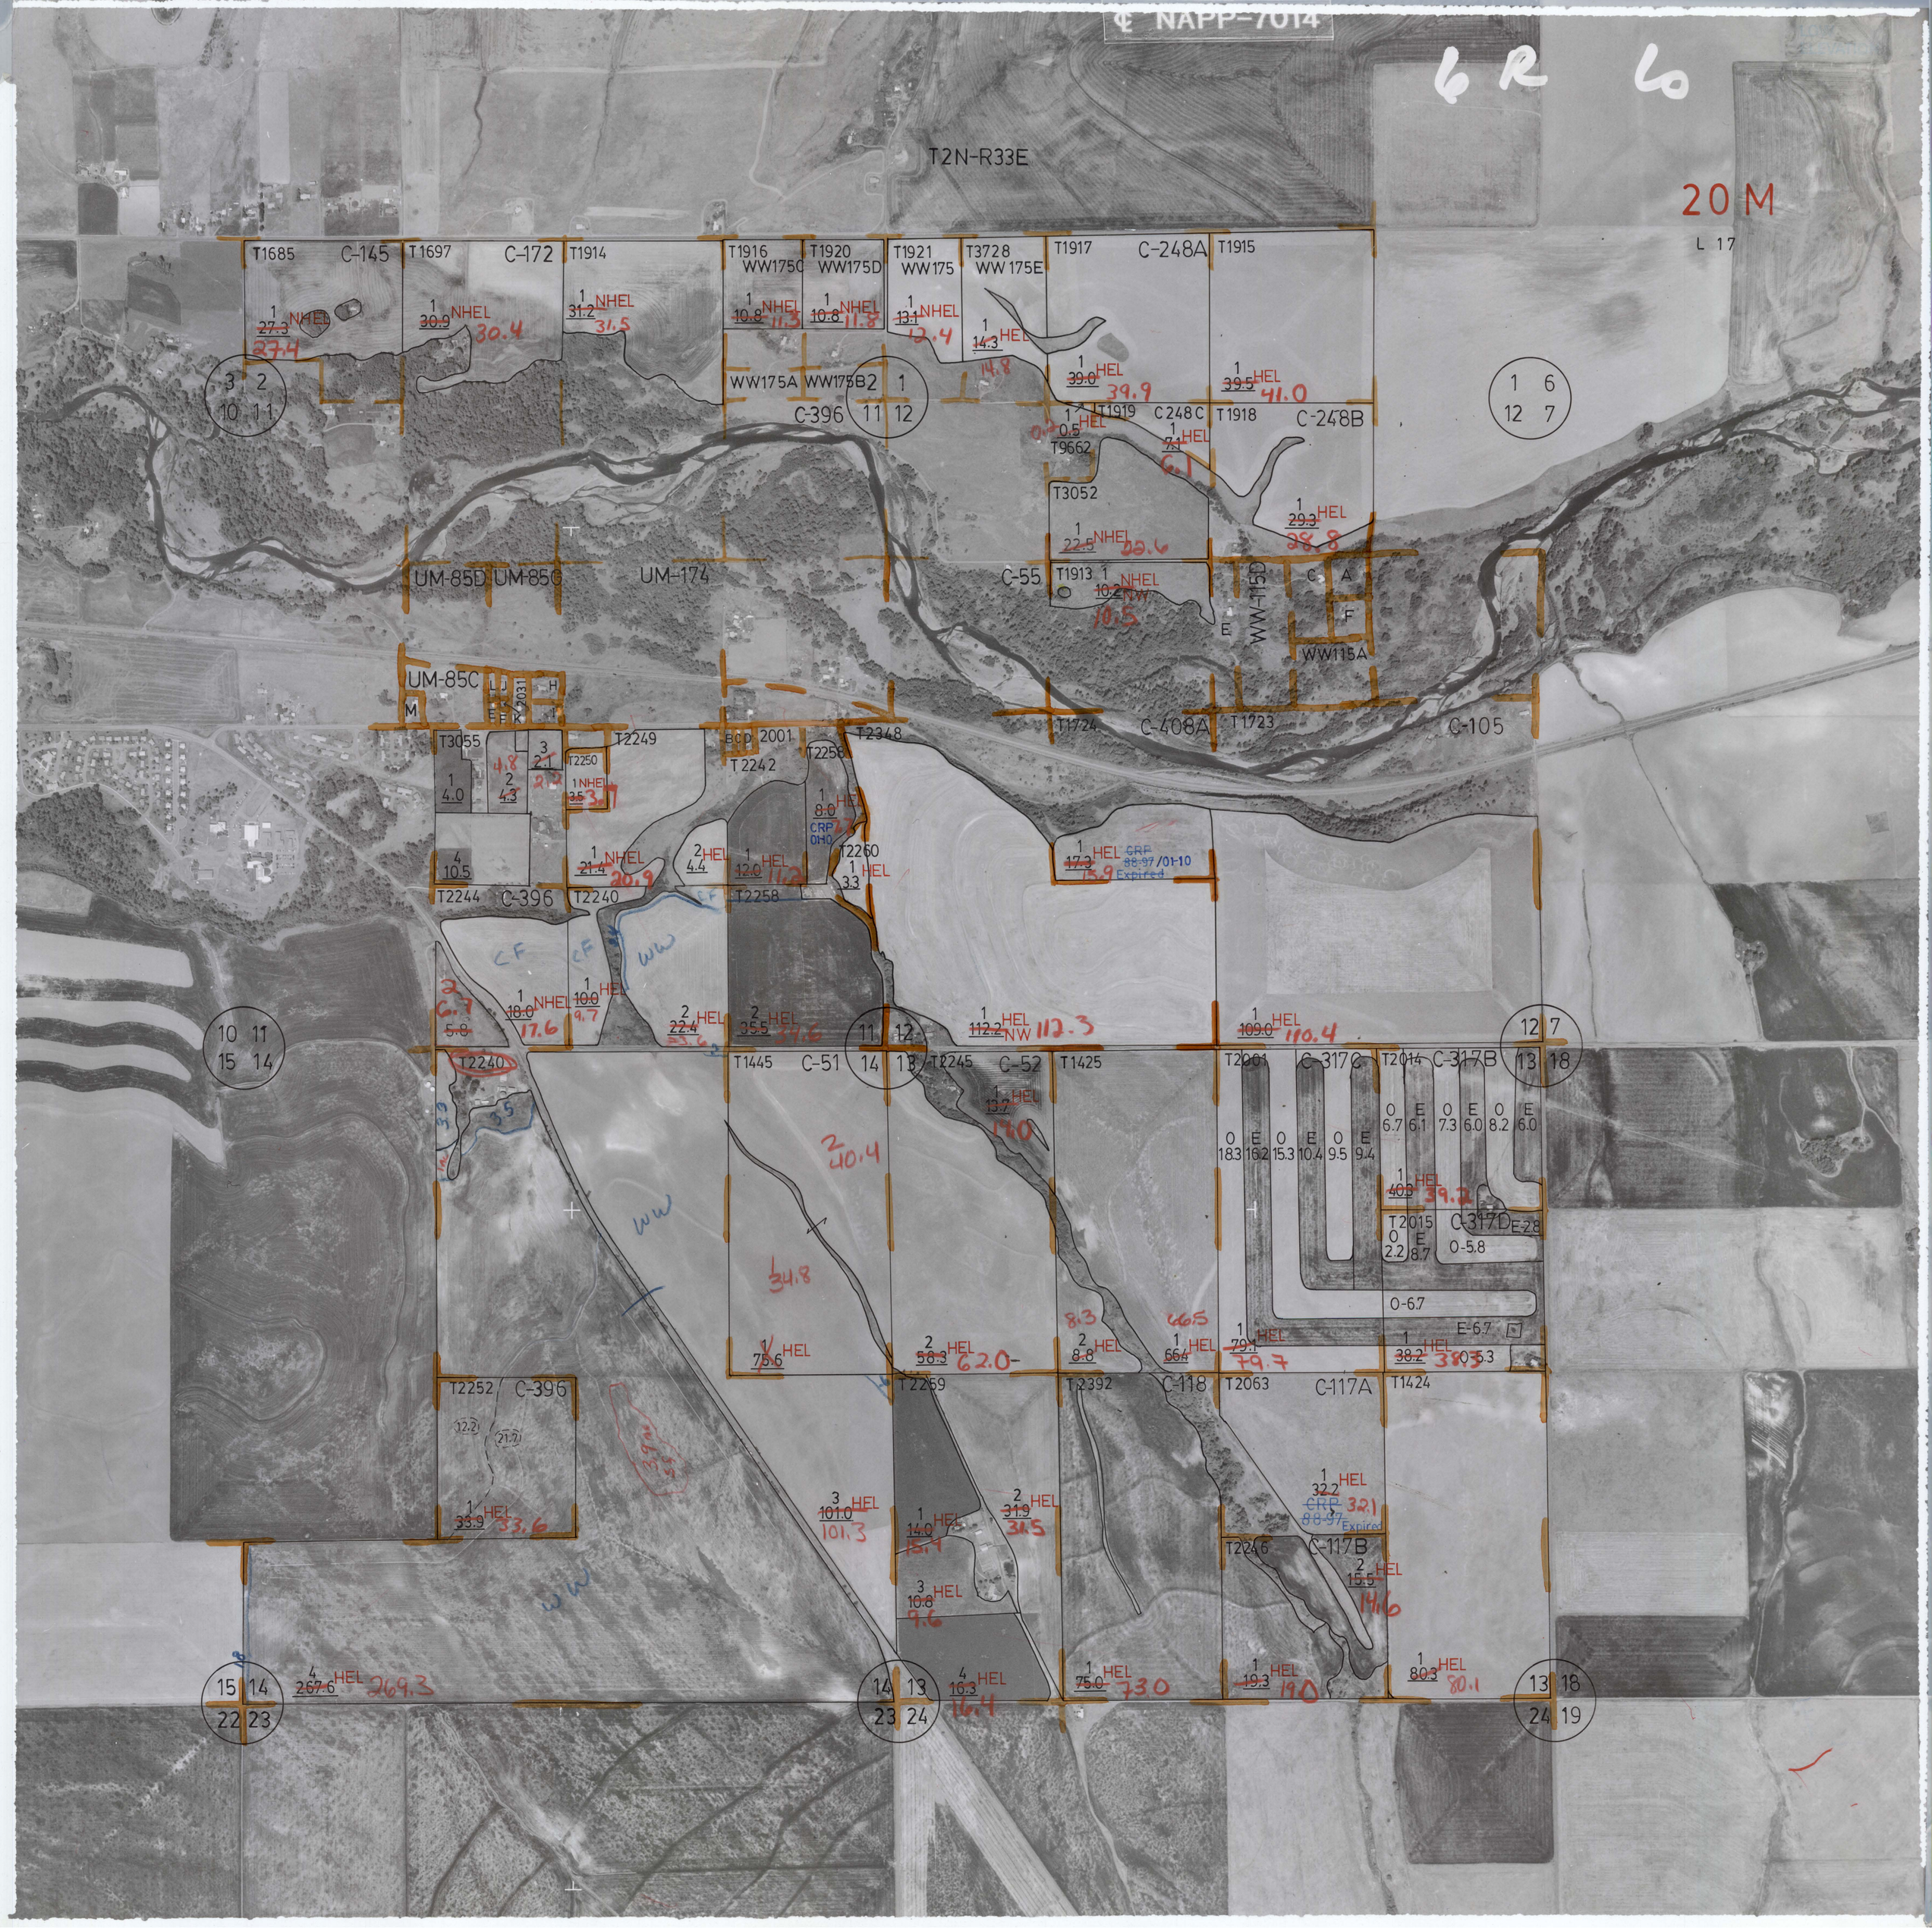

NAPP-7014
6R 6
20M
L 17
T2N-R33E
T1685
C-145
T1697
C-172
T1914
T1916
WW175C
T1920
WW175D
T1921
WW175
T3728
WW175E
T1917
C-248A
T1915
WW175A
WW175B
C-396
T1919
C248C
T1918
C-248B
T9662
T3052
UM-85D
UM-85C
UM-174
C-55
T1913
WW-115D
WW115A
UM-85C
T3055
T2249
T2250
T2242
T2258
T2348
T1724
C-408A
T1723
C-105
T2244
C-396
T2240
T2258
T2260
T2240
T1445
C-51
T2245
C-52
T1425
T2001
C-317C
T2014
C-317B
T2015
C-317D
T2252
C-396
T2259
T2392
C-118
T2063
C-117A
T1424
T2246
C-117B