


33 EL I'

CHAINED SCALES
1= 4062
2= 4683

210-2
C 18

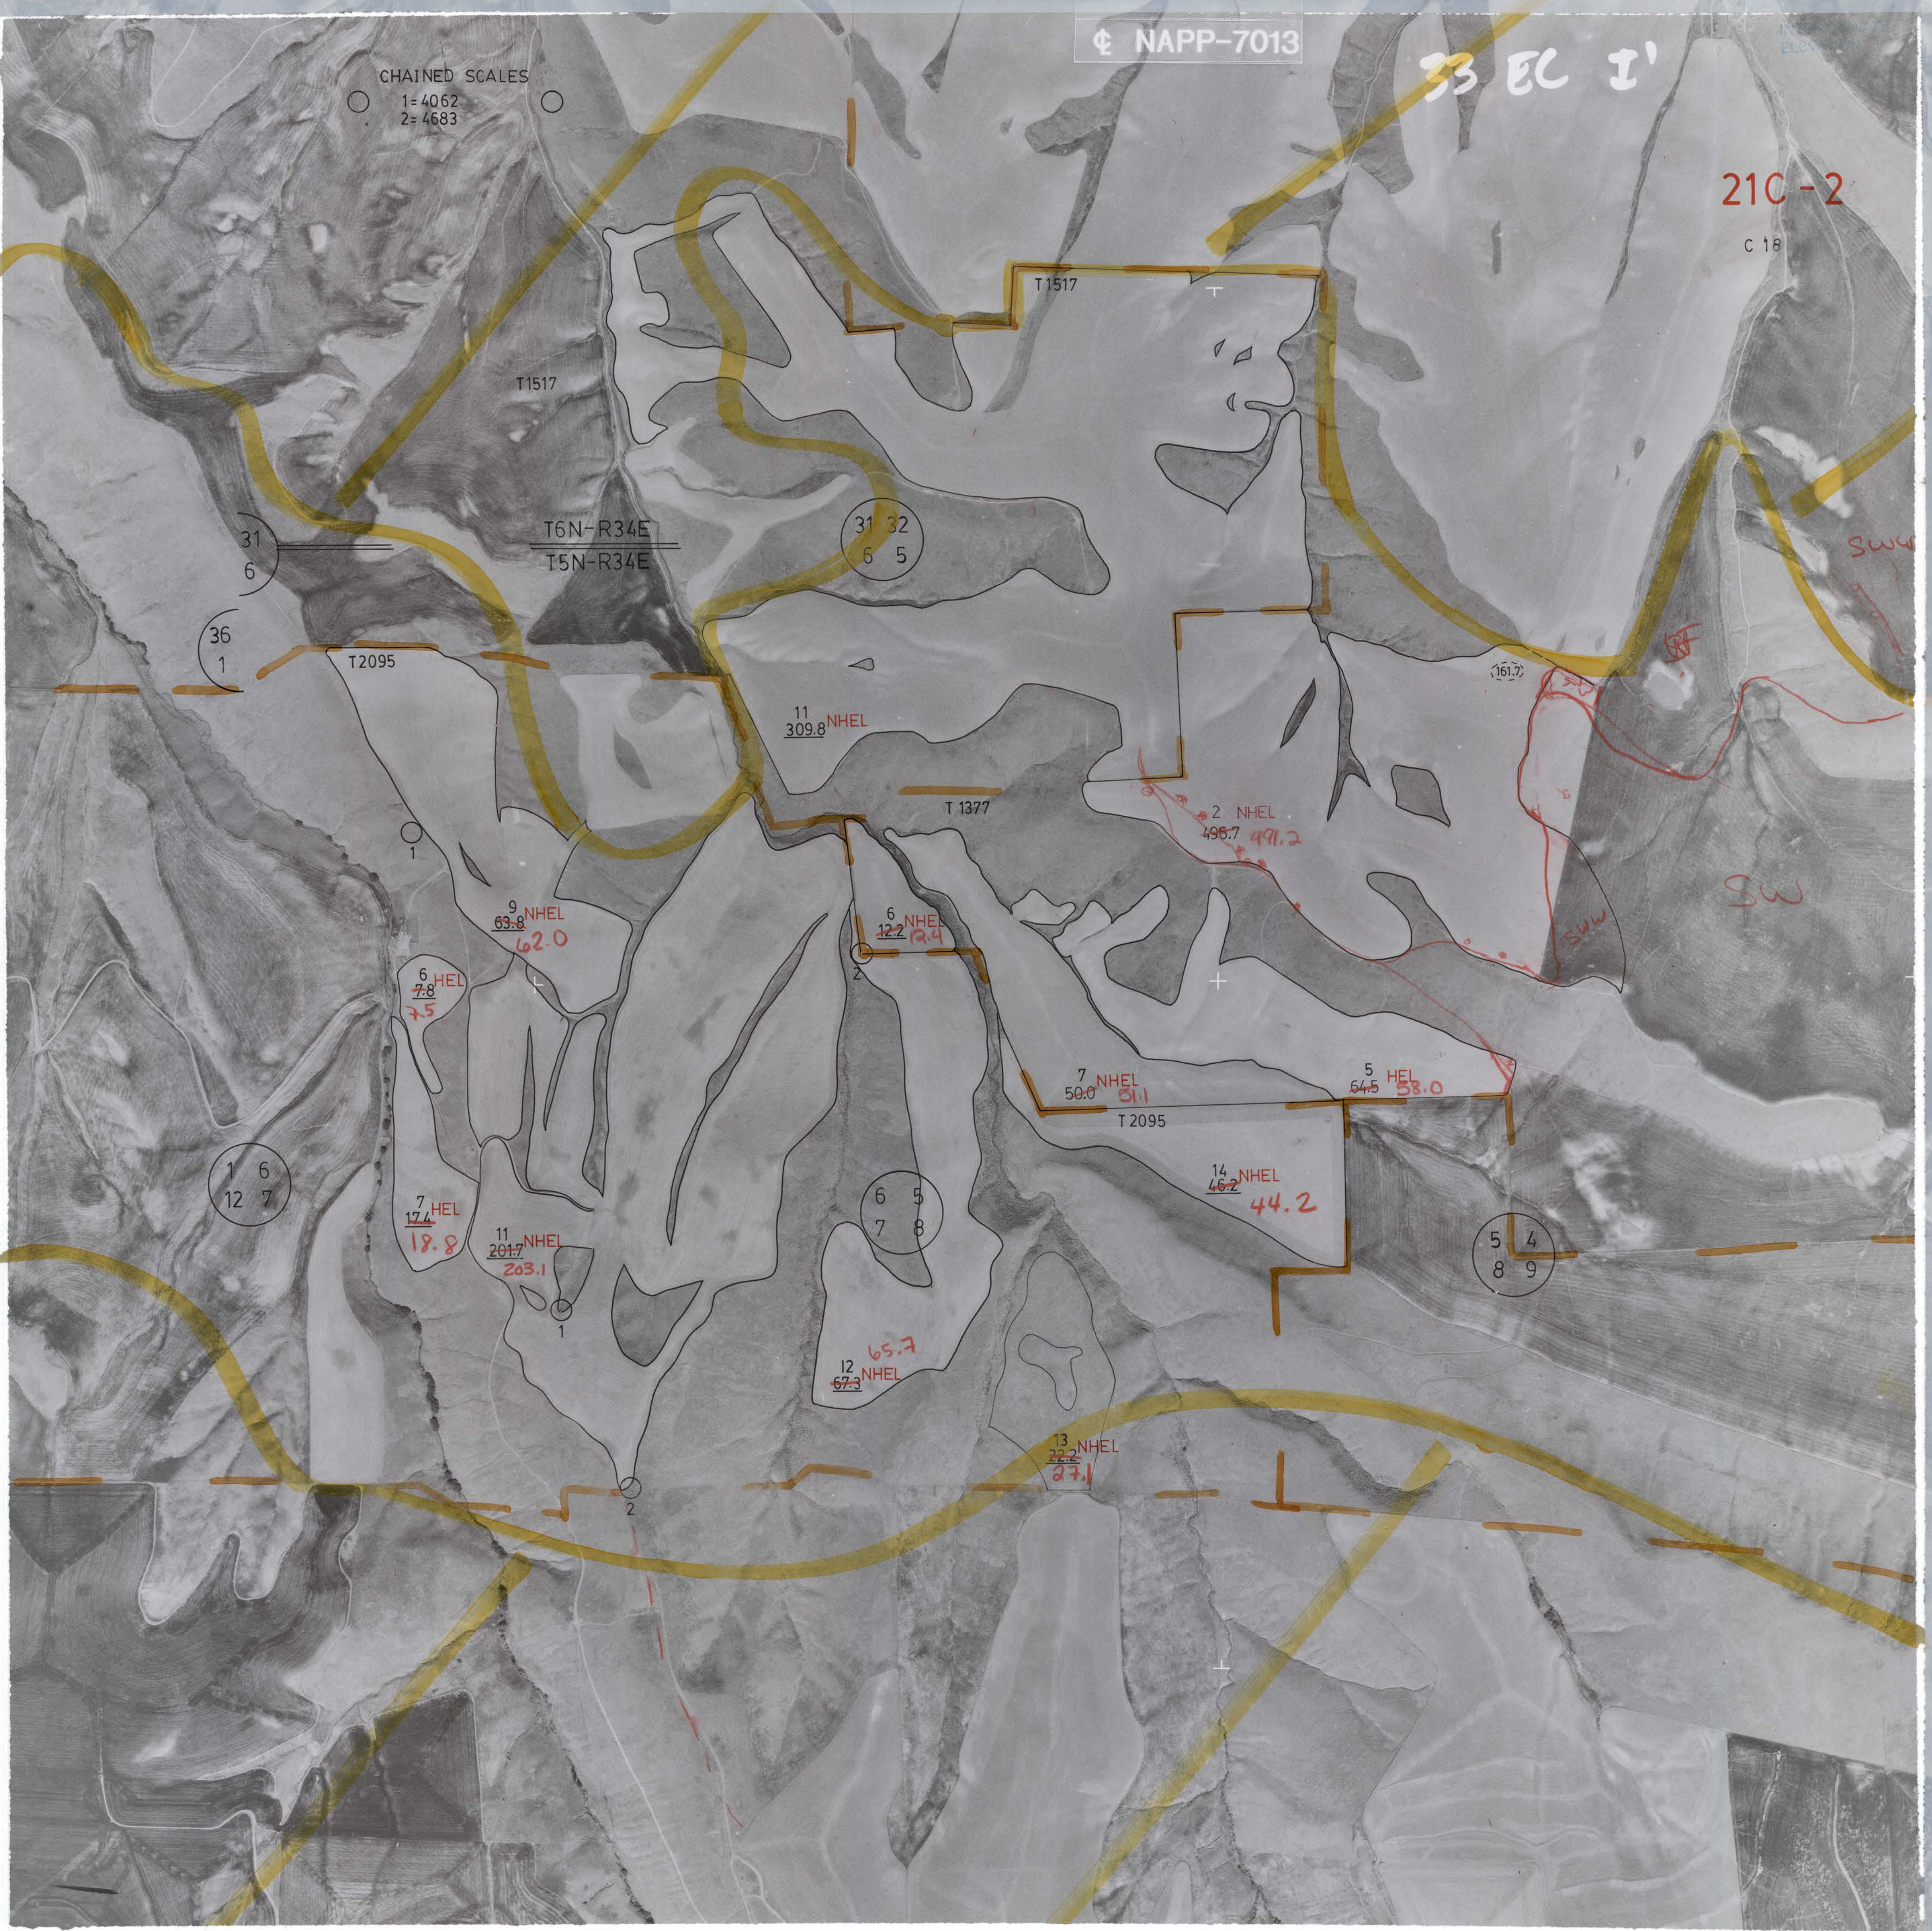

31
6

36
1

1 6
12 7

31 32
6 5

6 5
7 8

5 4
8 9

T1517

T6N-R34E
T5N-R34E

T2095

11 NHEL
309.8

T 1377

9 NHEL
63.8
62.0

6 HEL
7.8
7.5

6 NHEL
12.2
12.4

7 NHEL
50.0
51.1

5 HEL
64.5
58.0

7 HEL
17.4
18.8

11 NHEL
201.7
203.1

12 NHEL
67.3
65.7

14 NHEL
46.2
44.2

13 NHEL
22.2
27.1

T1517

(161.7)

SW

SW

SW