

☪ NAPP-7013

29 CB

Hi

21 H-1

CHAINED SCALE  
1=2631  
2=2708

T4N-R34E

13 18  
24 19

18 17  
19 20


17 16  
20 21

T1110

T303

T2107

H19

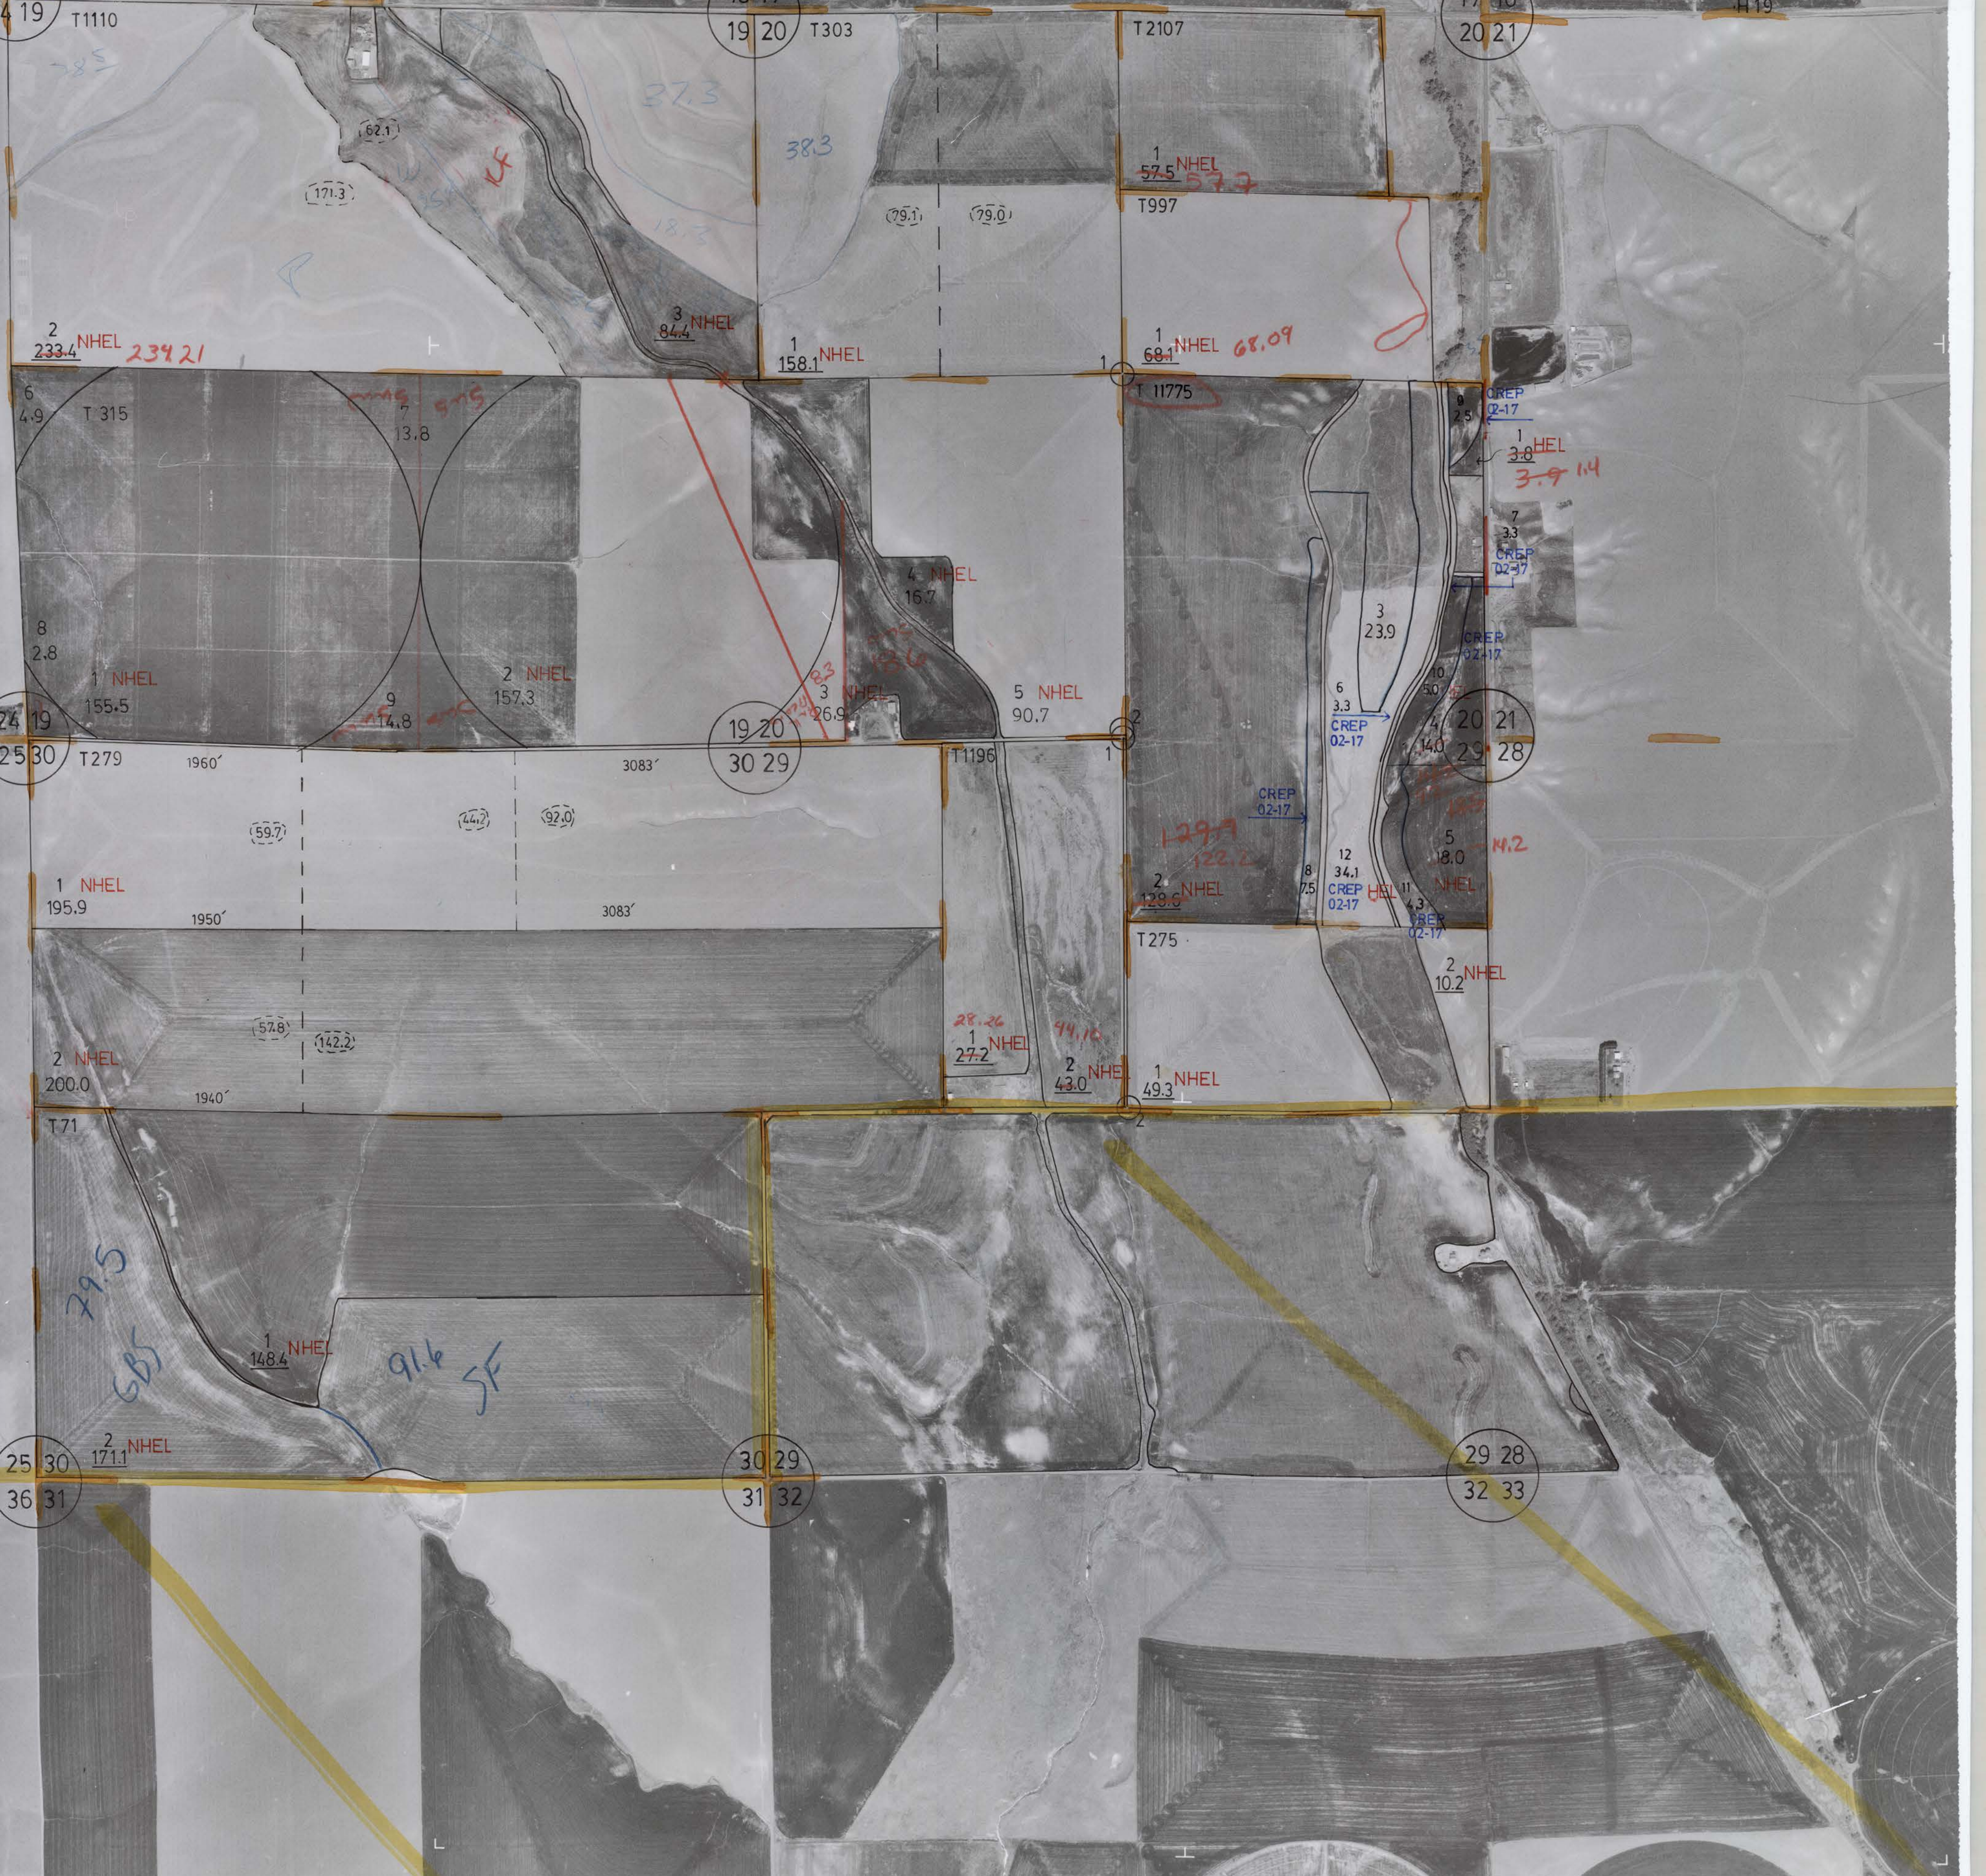

2 NHEL 233.4  
234.21

37.3  
38.3

1 NHEL 57.5  
57.7

1 NHEL 158.1

1 NHEL 68.1  
68.09

6 4.9  
T 315

7 13.8

9 CREP 2-17

1 NHEL 3.8  
3.9 1.4

8 2.8  
1 NHEL 155.5

9 14.8  
2 NHEL 157.3

4 NHEL 16.7

7 3.3  
CREP 02-17

19 20  
30 29

5 NHEL 90.7

3 23.9  
6 3.3  
CREP 02-17

10 20 21  
4 29 28  
11 14.2

24 19  
25 30

T279

1960'

3083'

T1196

CREP 02-17

1 NHEL 195.9

1950'

3083'

2 NHEL 129.6  
129.9  
122.2

12 34.1  
8 7.5  
CREP 02-17

11 4.3  
10 18.0  
5 14.2  
CREP 02-17


1940'

28.26  
1 NHEL 27.2

44.15  
2 NHEL 43.0

1 NHEL 49.3

2 NHEL 10.2

T71

79.5  
68.5

1 NHEL 148.4

91.6  
5F

25 30  
36 31

2 NHEL 171.1

30 29  
31 32

29 28  
32 33