


NAD 90 12-229 L 14

27 K-1

T3N R36E

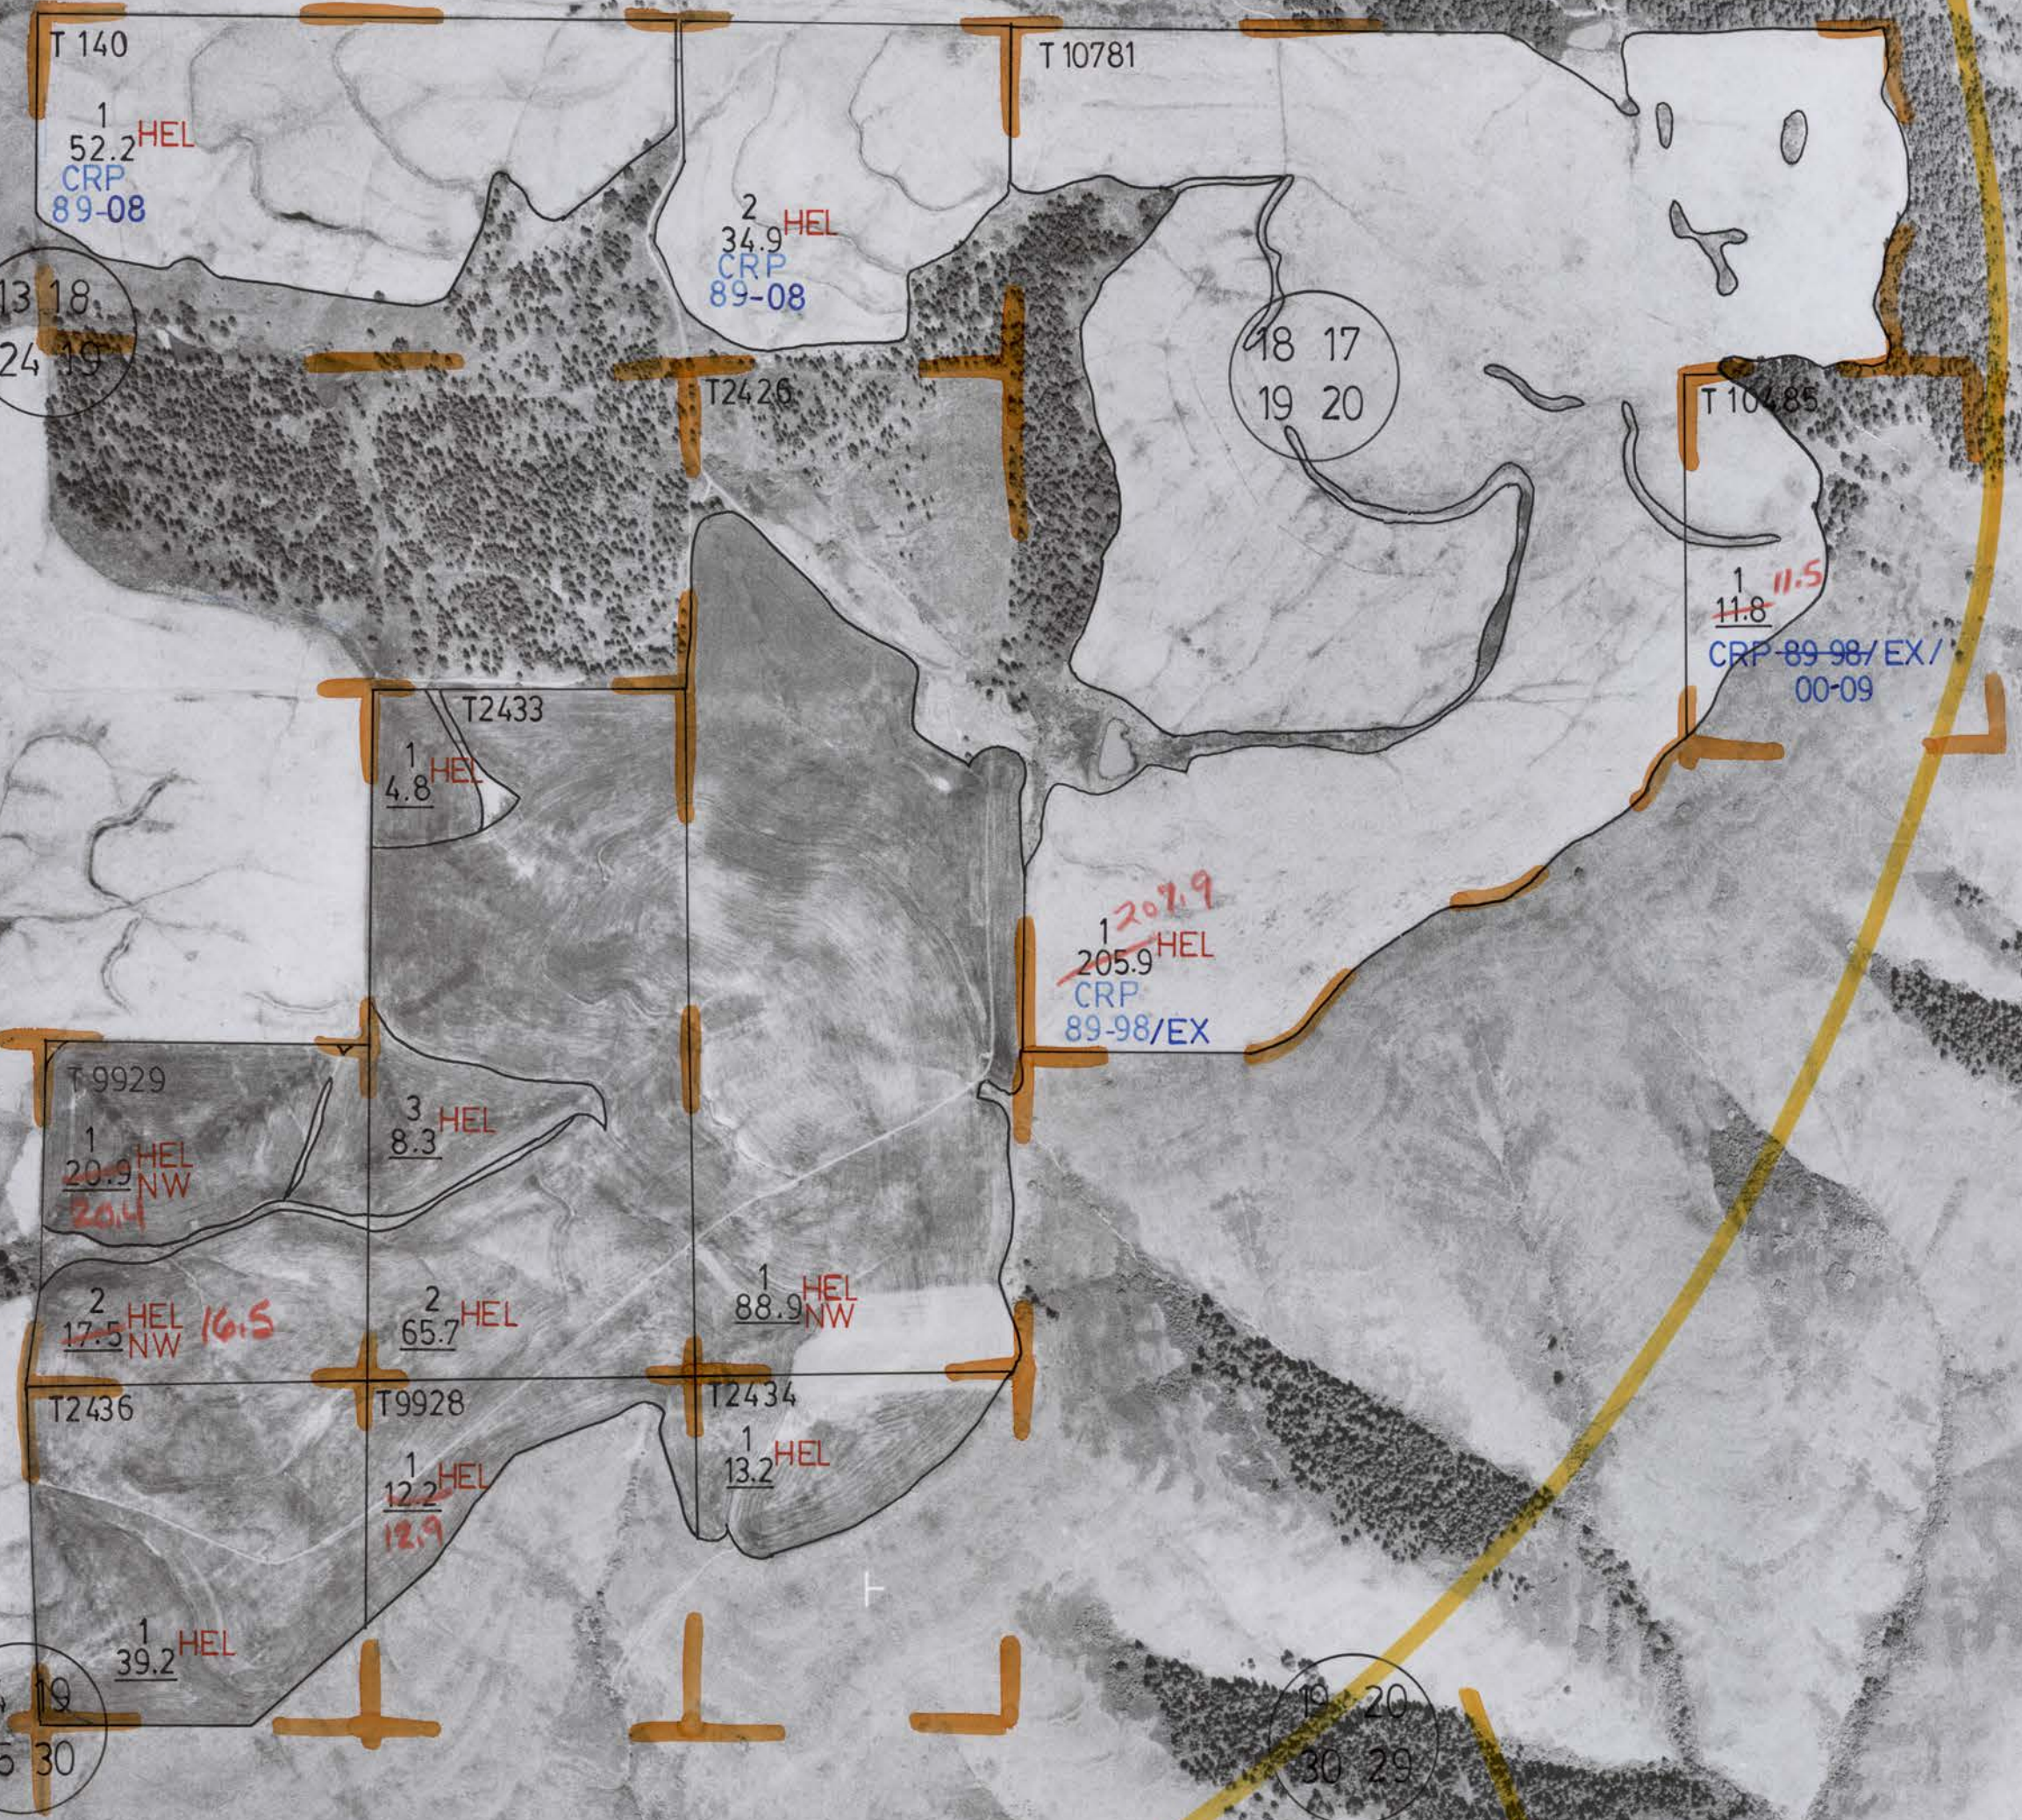

13 18, 24 19

18 17, 19 20

24 19, 25 30

19 20, 30 29