

142R

8H

67

T4N-R29E

T4N-R30E

15 14  
22 23

14 13  
23 24

13 18  
24 19

22 23  
27 26


24 25  
26 25

24 19  
25 30

27 26  
34 35

26 25  
35 36

25 30  
36 31

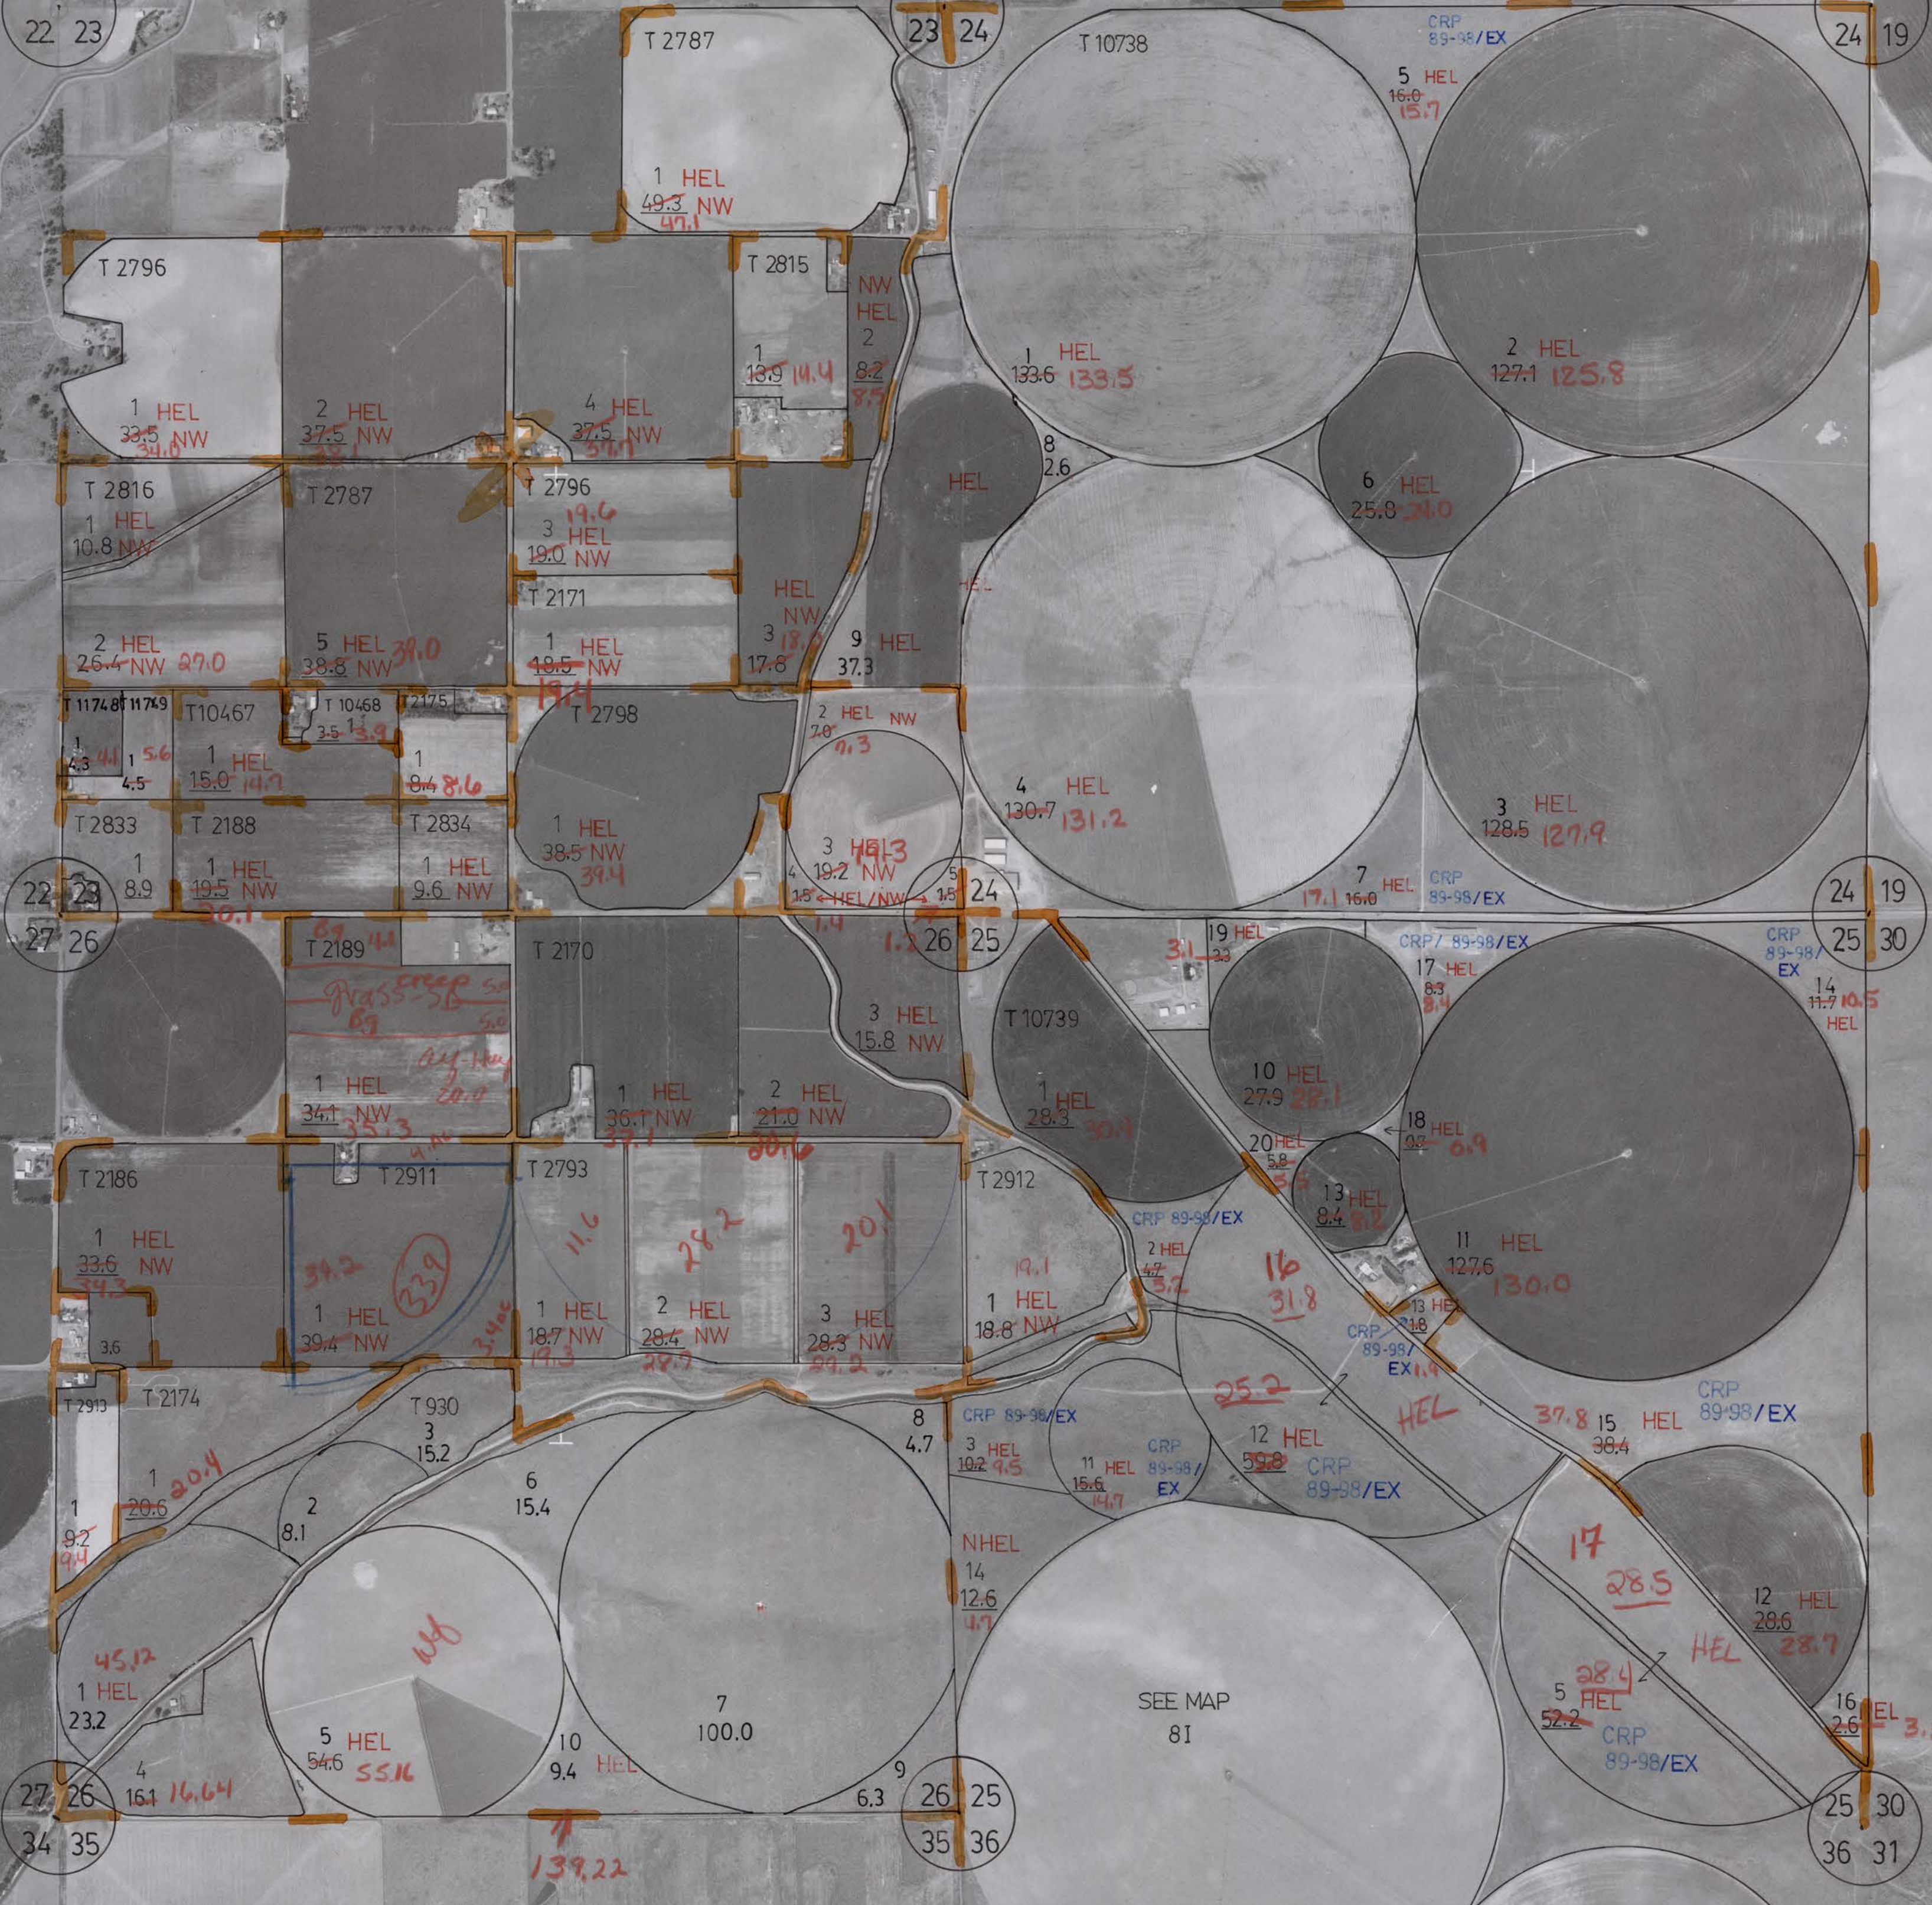

SEE MAP  
81

5 HEL  
54.6  
55.6

17  
28.5  
5 HEL  
52.2  
CRP  
89-98/EX

12 HEL  
28.6  
HEL  
28.7

16 HEL  
2.6  
3.5

10 HEL  
9.4

8 HEL  
14  
12.6  
4.7

9 HEL  
6.3

11 HEL  
15.6  
14.7

12 HEL  
55.8  
CRP  
89-98/EX

13 HEL  
8.4  
8.2

14 HEL  
11.7  
10.5












