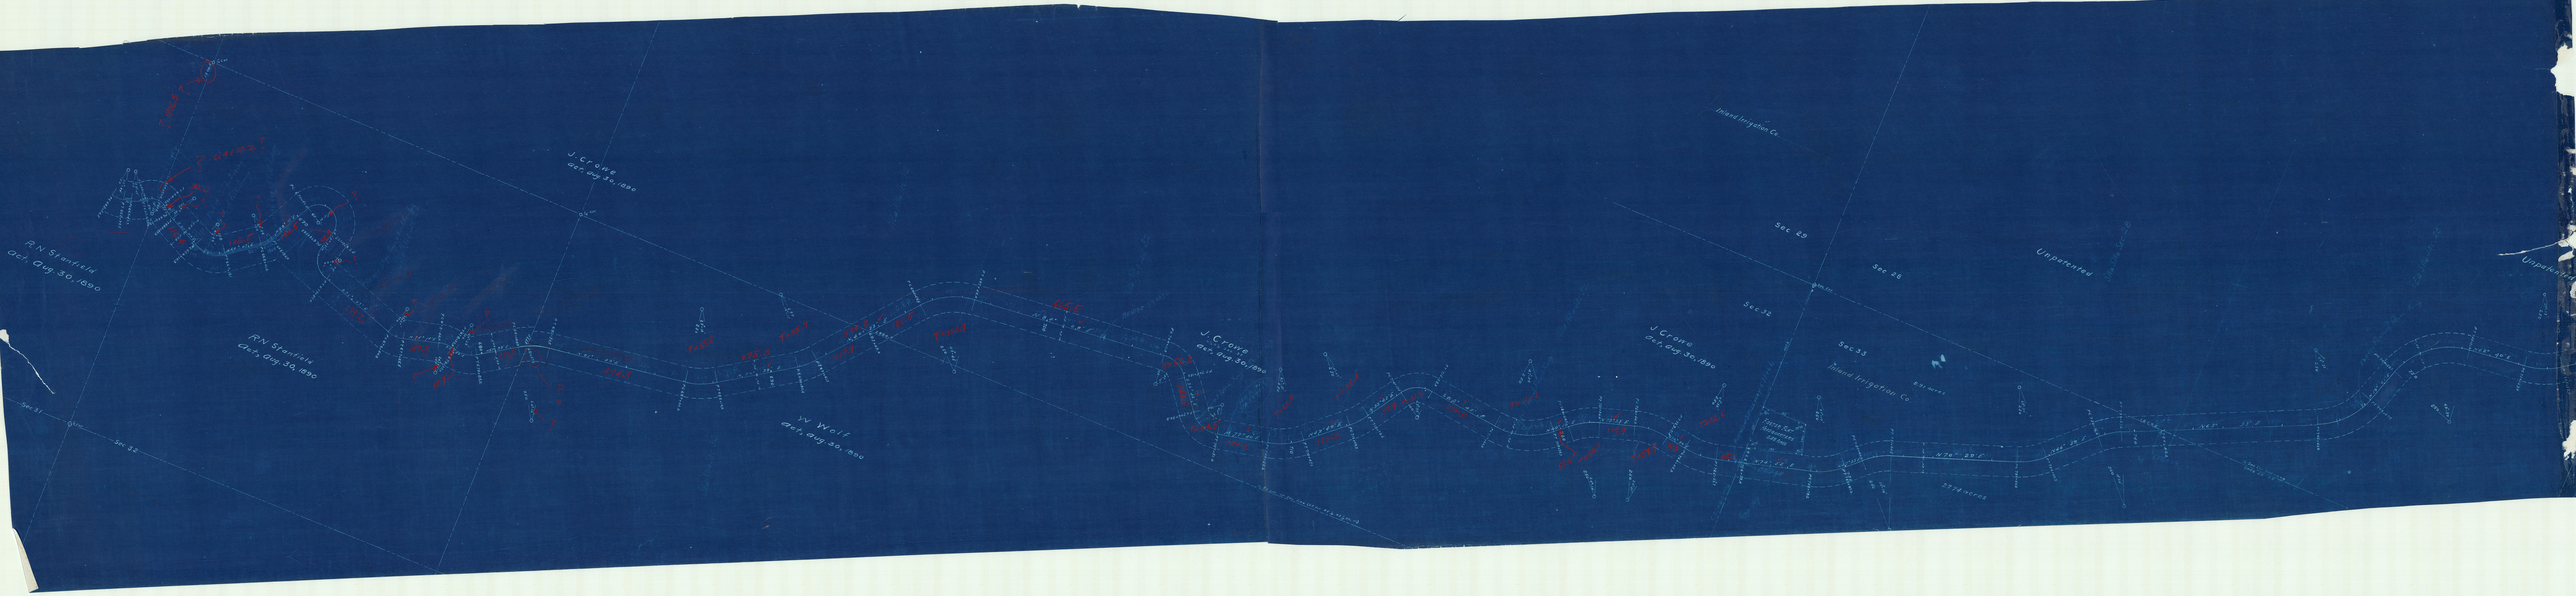
R.N. Stanfield
act. Aug 30, 1890
R.N. Stanfield
Act. Aug 30, 1890
J. Crane
act. Aug 30, 1890
N. Wolf
Act. Aug 30, 1890
J. Crane
Act. Aug 30, 1890
J. Crane
Act. Aug 30, 1890
Inland Irrig. Co.
Sec 29
Sec 26
Sec 32
Sec 35
Unpatented
Inland Irrigation Co.
Sec 31
Sec 32