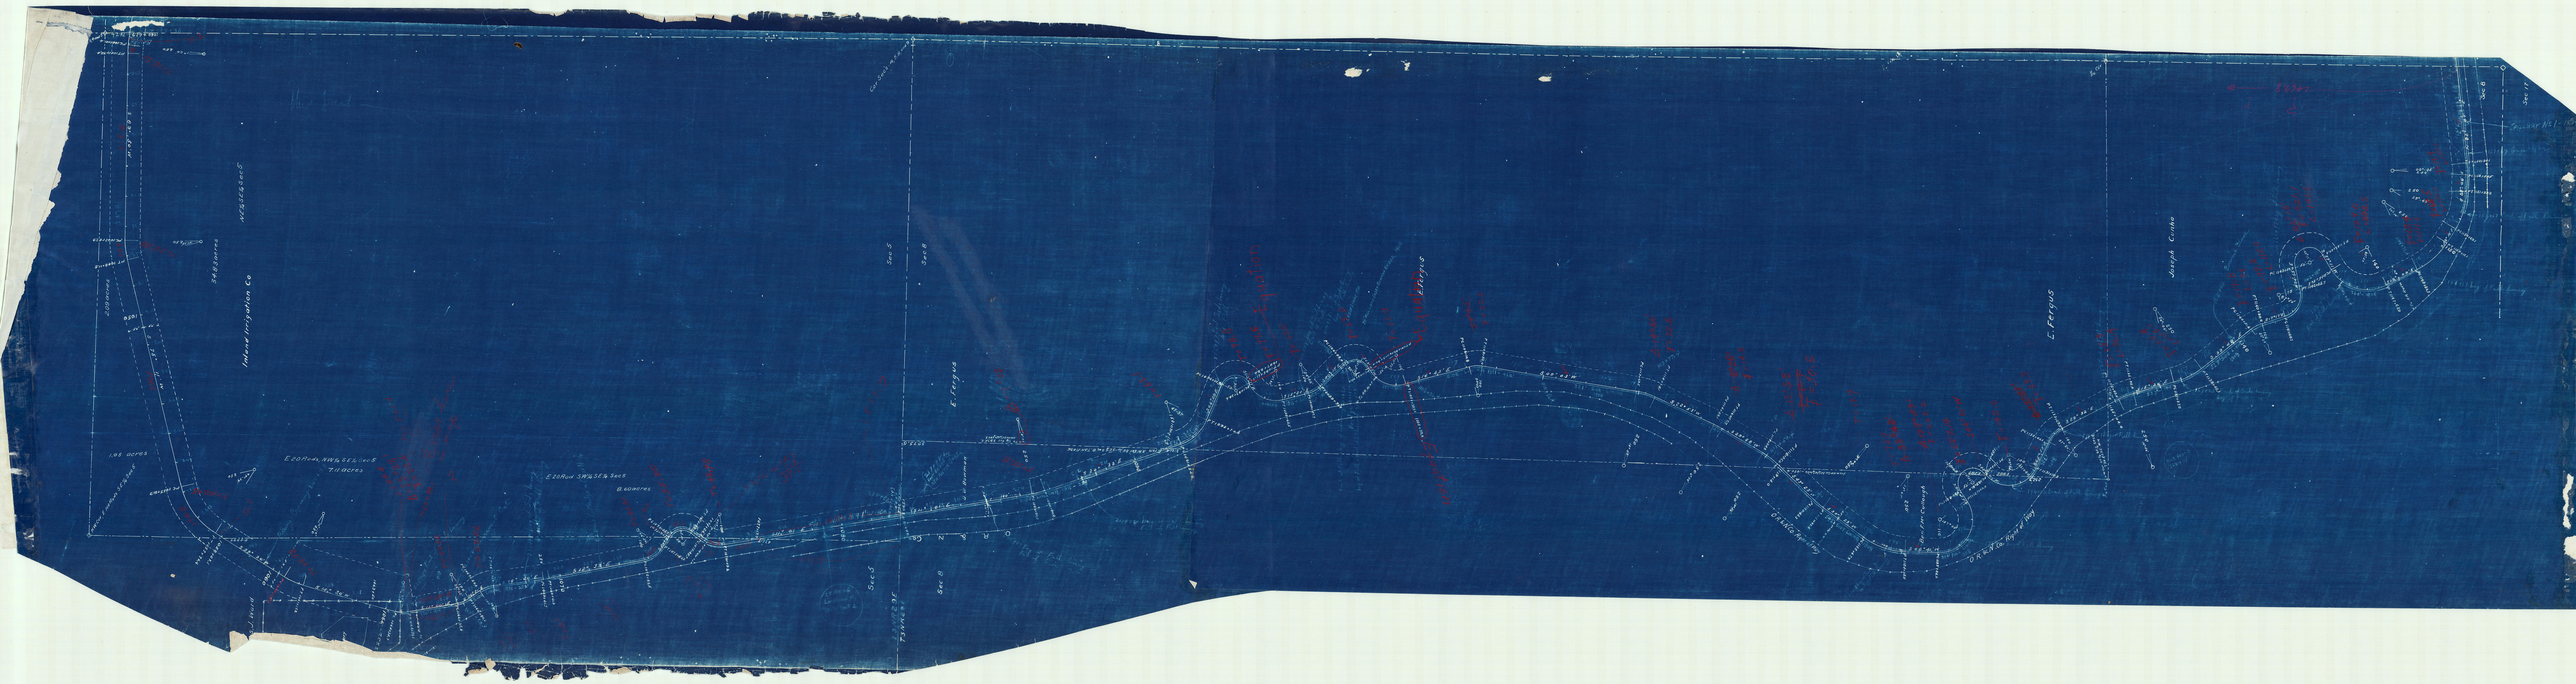
Sec 5
Sec 8
E. Fergus
L. Fergus
Sec 5
Sec 8