OREGON STATE HIGHWAY DEPARTMENT

UMATILLA COUNTY

CITY of UMATILLA

"G" & "I" STREETS

CONSTRUCTED — ~~LOCATED "L"~~ LINE

Scale 1" = 50' Length of project 0.30 Mi.

A. J. Wallace Res. Engr. 1951

W. S. Hodge - Res. Engr. - Const. 1951

5F 18-5

SH. 1

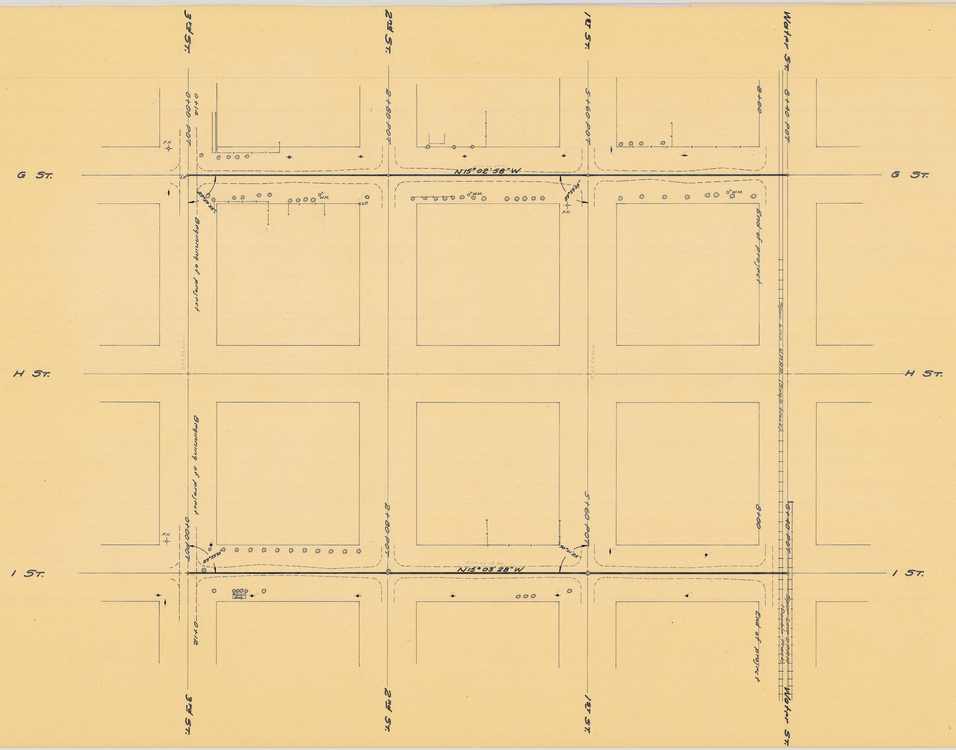
3rd St.
2nd St.
1st St.
Water St.
G St.
H St.
I St.
N 18°02'38" W
N 18°02'38" W
Line of property
Line of property
Line of property