

← Walla Walla River ←

Stone Mon.

Street N 65° E

850.8


George N 65° E

PLAT OF GEORGE STREET SURVEY.

Scale 1"=100'

Oct. 25 1910.

Willard Bradley

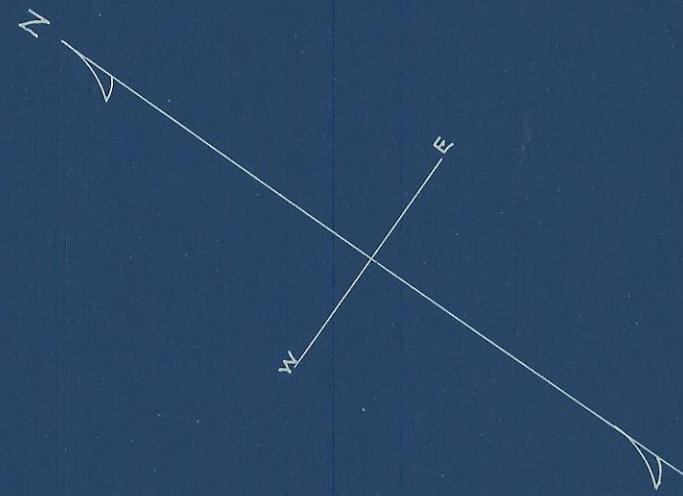

Note: This is a copy of the plat found at page 81 of the Milton City Plat Book at Milton Oregon. However this plat does not appear on the public official records of Umatilla County Oregon. Hartman Abstract Company Pendleton Oregon.

90°

Grove St.

Stone Mon.

360'

N. 25° W

Stake Tack

To Mon. in Elzora St.

Iron pin

300.0'

Stake

11-159-A
(5N 35 12 BA)