


Noontz Second Addn
to the
City of Echo.

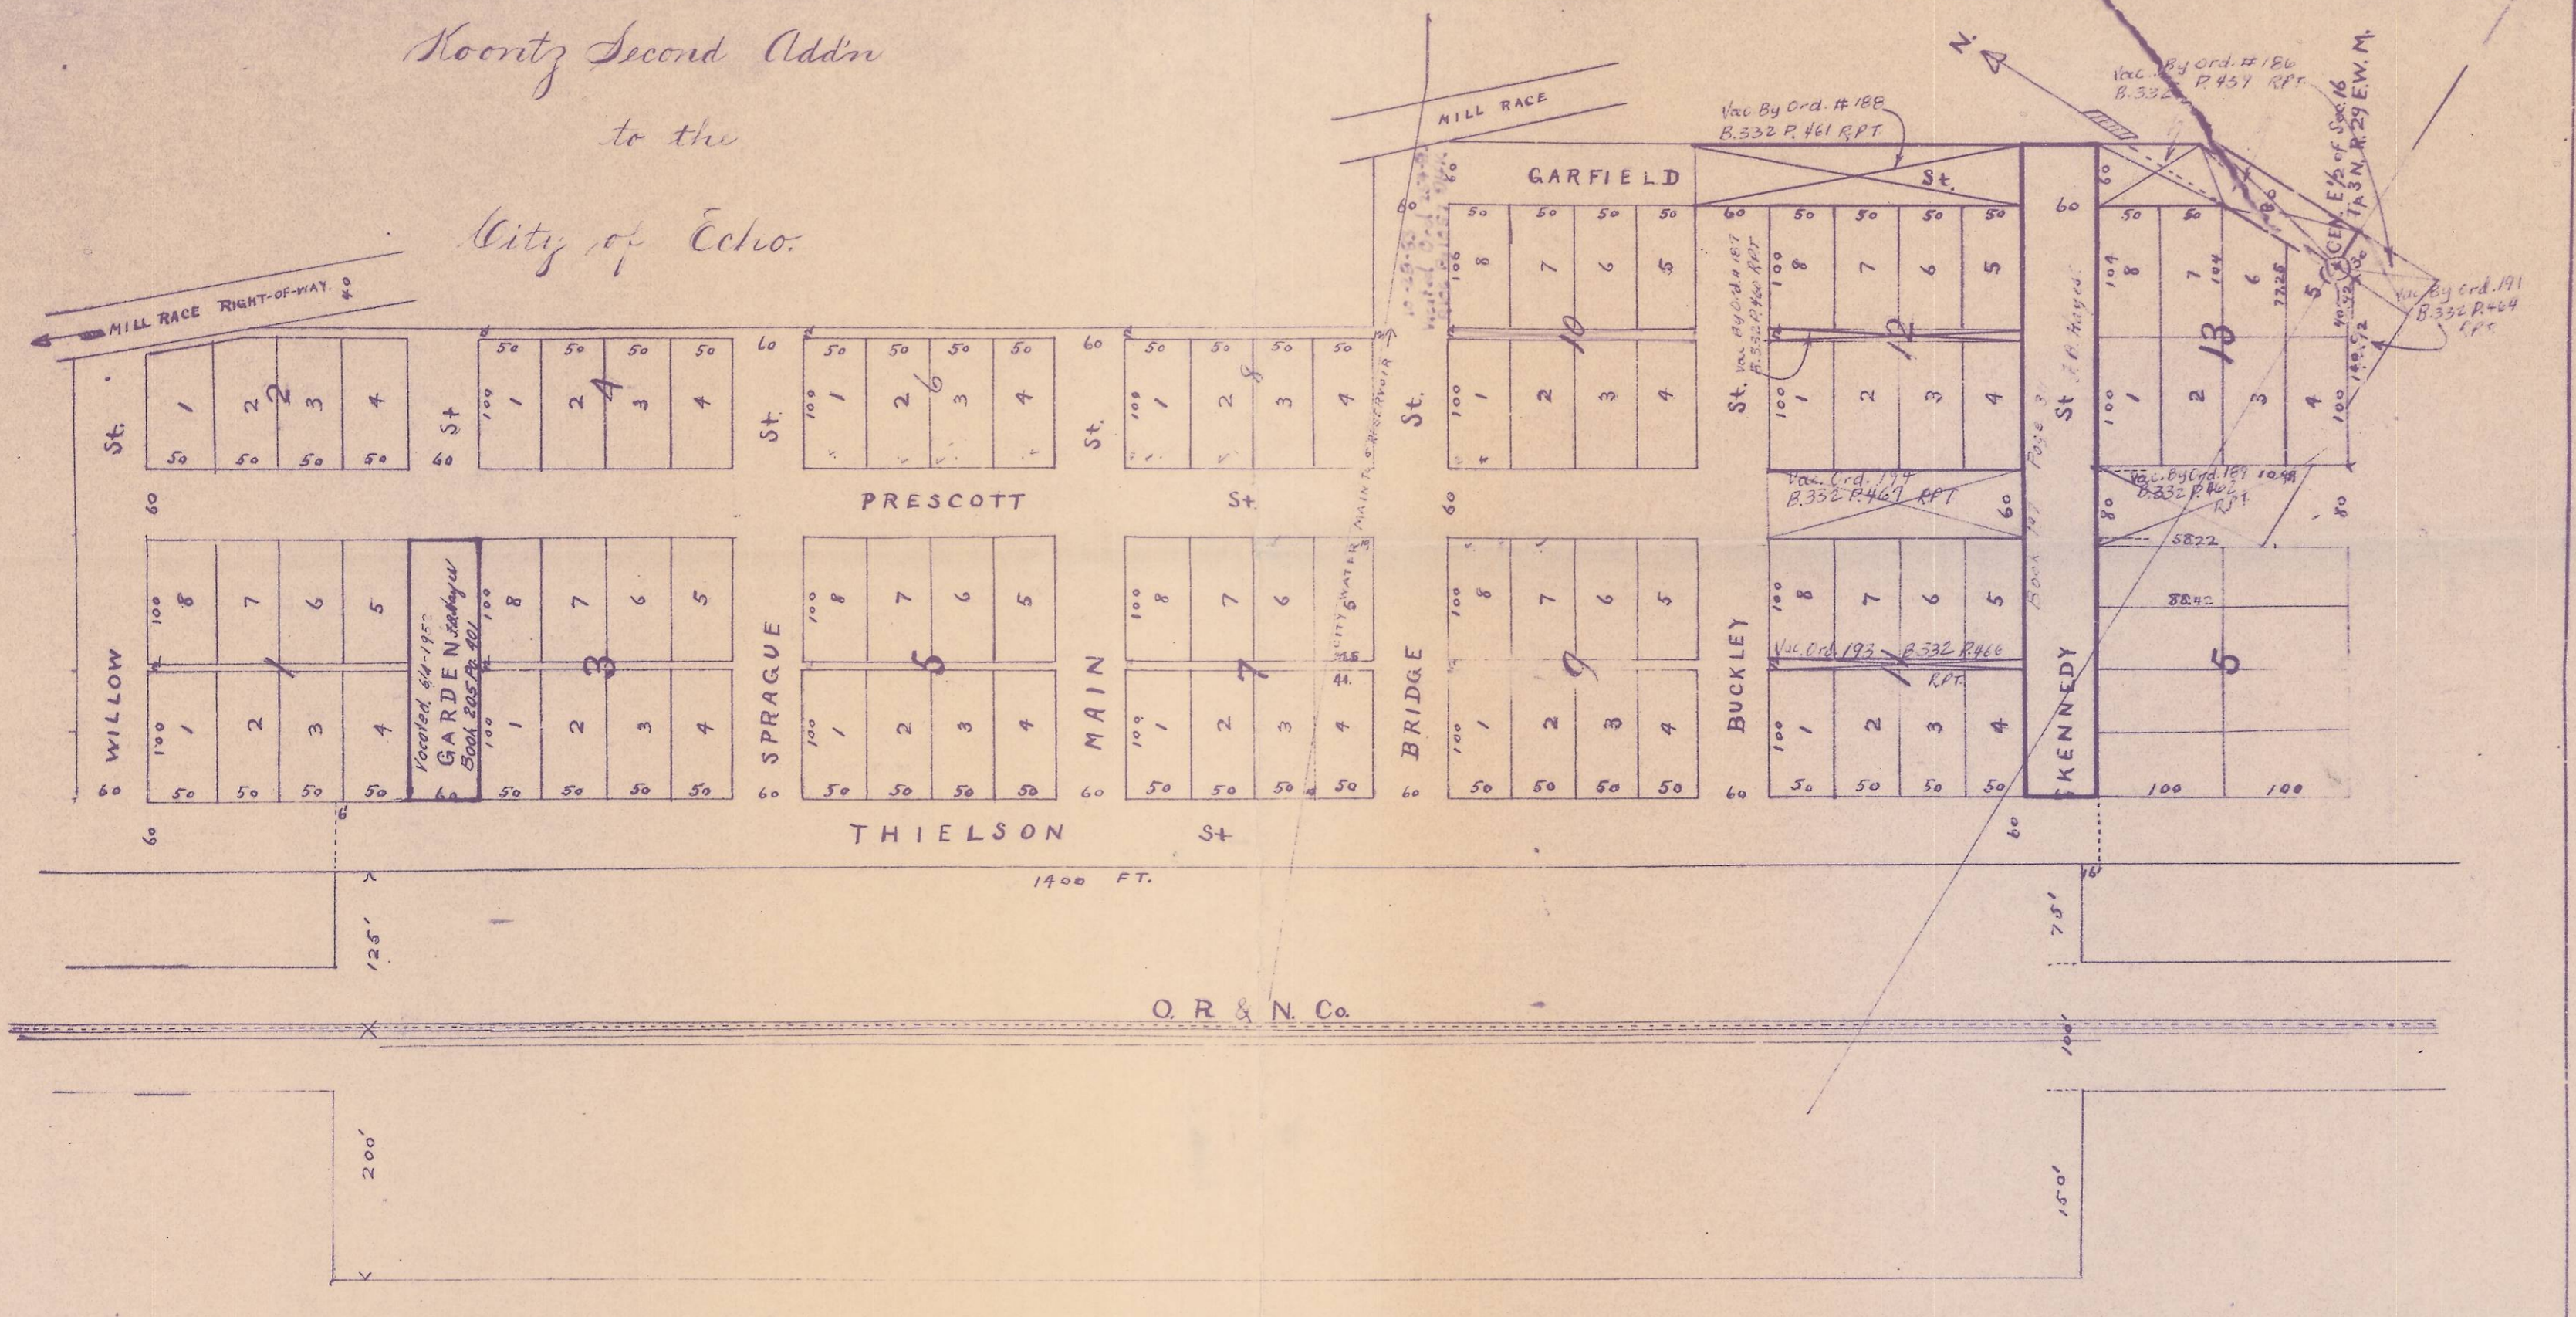

Know all men by these presents, That we,
J. K. Noontz and Cynthia A. Noontz, husband
and wife, of Echo, Umatilla County, State of Oregon, do
hereby dedicate to and for the use of the public, all the
streets and Alleys in Noontz Second Addn to the
City of Echo, as shown by the plat hereunto attached,
and made a part of this addition.

Witness our hands and faces this 25th day
of April 1906.

Witness
Miss Blanch Grubb
Louise Scholl, Jr.
J. K. Noontz
Cynthia A. Noontz

Acknowledged before me this 25th day of April 1906.
Louise Scholl, Jr.
Notary Public for Oregon.

Louise Scholl, Jr.
Notary Public
State of Oregon.

Approved this 23 day of May 1906
H. P. Stearns
County Assessor.

Approved this 23 day of May 1906
J. H. Kinnaman
County Surveyor
By Snow Kinnaman
Deputy County Surveyor.

I, Frank Saling, County Clerk of Umatilla County,
State of Oregon, and official clerk of the county court, do hereby
certify that the within plat has been approved by the County
Court.

In Testimony whereof I have hereunto set my hand and the
seal of said court this 24th day of May 1906.

Frank Saling, County Clerk
By P. S. Brown, Deputy

RECEIVED BY
Umatilla County Surveyor
Date: 5/23/12
Rec'd By: S. O.
No.: 12-080-B

STATE OF OREGON,
County of Umatilla, } ss.
This instrument was filed for record on
the 24th day of May, A.D. 1906,
at 1:30 o'clock P.M. and duly recorded
in Vol. 2 of 1906
Page 7
By [Signature] Recorder
By [Signature] Deputy
Per 12:00 No. 233