


### Halstead's Addition to Town of Echo

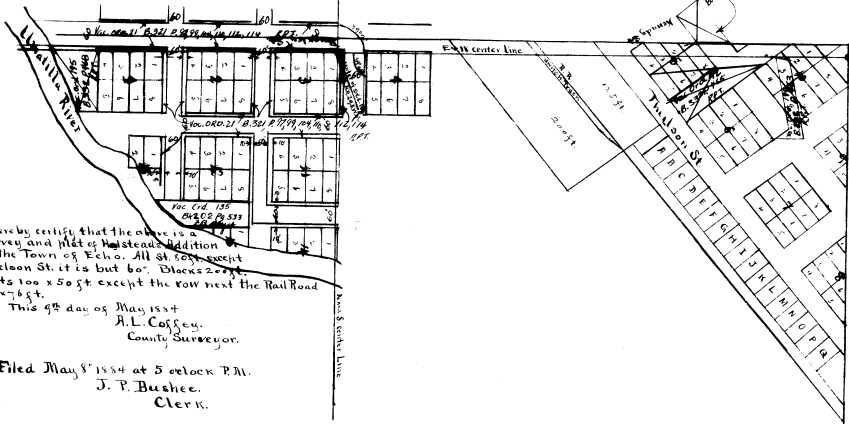

I hereby certify that the above is a true and correct survey and plat of Halstead's Addition to the Town of Echo. All St. 60 ft. except Union St. it is but 60'. Blocks 200 ft. Lots 100 x 50 ft. except the row next the Rail Road so 47 1/2 ft.

This 9th day of May 1884  
 A. L. Coffey,  
 County Surveyor.

Filed May 8 1884 at 5 o'clock P.M.  
 J. P. Bushee,  
 Clerk.

Know all men by these Presents that we Joel Halstead and Emma Halstead his wife do grant and convey to the public all streets marked on this Plat. to have and to hold for the use of the Public as highways, in witness whereof we have herewith Set our Hands and Seals. this the 13th day of February A. D. 1909

Louis Scholl Jr. } Witnesses  
 O. D. Teal }  
 Signed and Sealed and delivered in the Presence of : Louis Scholl Jr. :  
 Acknowledged before me Feb. 13th 1909. } Notary Public for Oregon STATE OF OREGON

I hereby certify that the above Plat of Halsteads Addition to the town of Echo lying in the N.W. 1/4 of S.E. 1/4 and the N.E. 1/4 of S.W. 1/4 of Sec. 16 T. 3 N R 29 E W 4 is a correct Copy or Duplicate of the Original Plat as Surveyed by A.L. Coffey in 1884 and filed in the County Clerks Office (Now Recorder) in Book K. Page 591 on the 8th day of May A.D. 1884 at 5 o'clock P.M. and that this Plat and Certificate is for the Purpose of correcting and curing any defects or errors that may be found in Original Plat and Record as on file in Book K. Page 591 as above stated.

John W. Kimbrell County Surveyor  
 for Umatilla County Oregon.

Approved the 19 day of Feb. A. D. 1909  
 O. P. Strain  
 Assessor

STATE OF OREGON )  
 County of Umatilla ) SS  
 I Frank Saling County Clerk of Umatilla County State of Oregon and ex officio Clerk of the County Court do hereby certify that the within Plat has been approved by the County Court.  
 In Testimony Whereof I have hereunto set my hand and the Seal of said Court this 19 day of Feb. 1909

FRANK SALING  
 COUNTY CLERK  
 UMATILLA COUNTY,  
 STATE OF OREGON

Frank Saling Clerk  
 R. T. Brown Deputy

Filed for record Feb'y 23rd. 1909,  
 at 9:50 A. M.

Frank W. Needles,  
 Recorder of Conveyances.

