


NARRATIVE

The purpose of this survey was to set the corners of a 180 foot square parcel in the Northeast corner of that parcel belonging to the Oregon Bank as recorded on Page 098 of Roll 34 of the Dead Records of Umatilla County, Oregon. The pins shown as found were set by Don Staebler in May 1978, for the Oregon Bank, as shown on Umatilla County Survey Records drawing no. P-971-C.

Bearings are based upon the above said Umatilla County Survey Records drawing no. P-971-C.

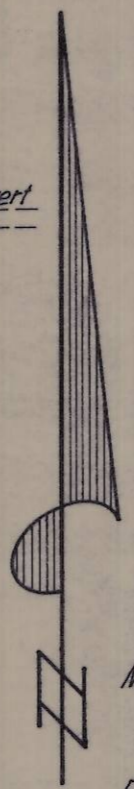

- denotes 1/8 in. x 30 in. iron pin with aluminum cap set
- denotes 1/8 in. iron pin found
- () denotes bearing or distance of record
- M.H. ● denotes sanitary manhole
- denotes water valve
- F.H. ◆ denotes fire hydrant
- C.B. □ denotes catch basin

REGISTERED PROFESSIONAL LAND SURVEYOR
 OREGON JULY 17, 1970
 DAVID H. KRUMBEIN
 933

David H. Krumbein

RECEIVED BY
 Umatilla County Surveyor
 Date 10-8-82
 Rec'd By BLS
 No. 82-33-A

KRUMBEIN ENGINEERING CO. ENGINEERS - SURVEYORS - PLANNERS 221 S. Main, Pendleton, Oregon	SCALE 1" = 50'
	DATE April 8, 1982
Survey for PAUL SEAQUIST located in NW 1/4, 6W 1/4, Section 1, T5N, R35E, W1W.	DRN. BY M.H.
	CKD. BY D.H.K.
	DRNG. NO. 82-11B

82-33-A Job No. 82-44