

SURVEY IN BLOCK 7,  
 OLINGER'S ADDITION,  
 IN SW. 1/4 NE 1/4 SEC. 2, T5N, R35E, W.M.  
 MILTON-FREEWATER, OREGON  
 FOR: WILLARD WEST & K.W. MILLER  
 BY: VICTOR M. MCLIND, L.S. # 934  
 JAN. 1984 SCALE: 1"=50'

**LEGEND**


- MONUMENT FOUND AS NOTED
- SET 1/2" X 30" STEEL REBAR WITH 1" PLASTIC CAP
- CALCULATED POINT, NOT FOUND OR SET

REGISTERED  
 PROFESSIONAL  
 LAND SURVEYOR

*Victor M. Mc Lind*

OREGON  
 VICTOR M. MCLIND  
 934

RECEIVED BY  
 Umatilla County Survey  
 Date 3/84  
 Rec'd By BLC  
 No. 84-5-A

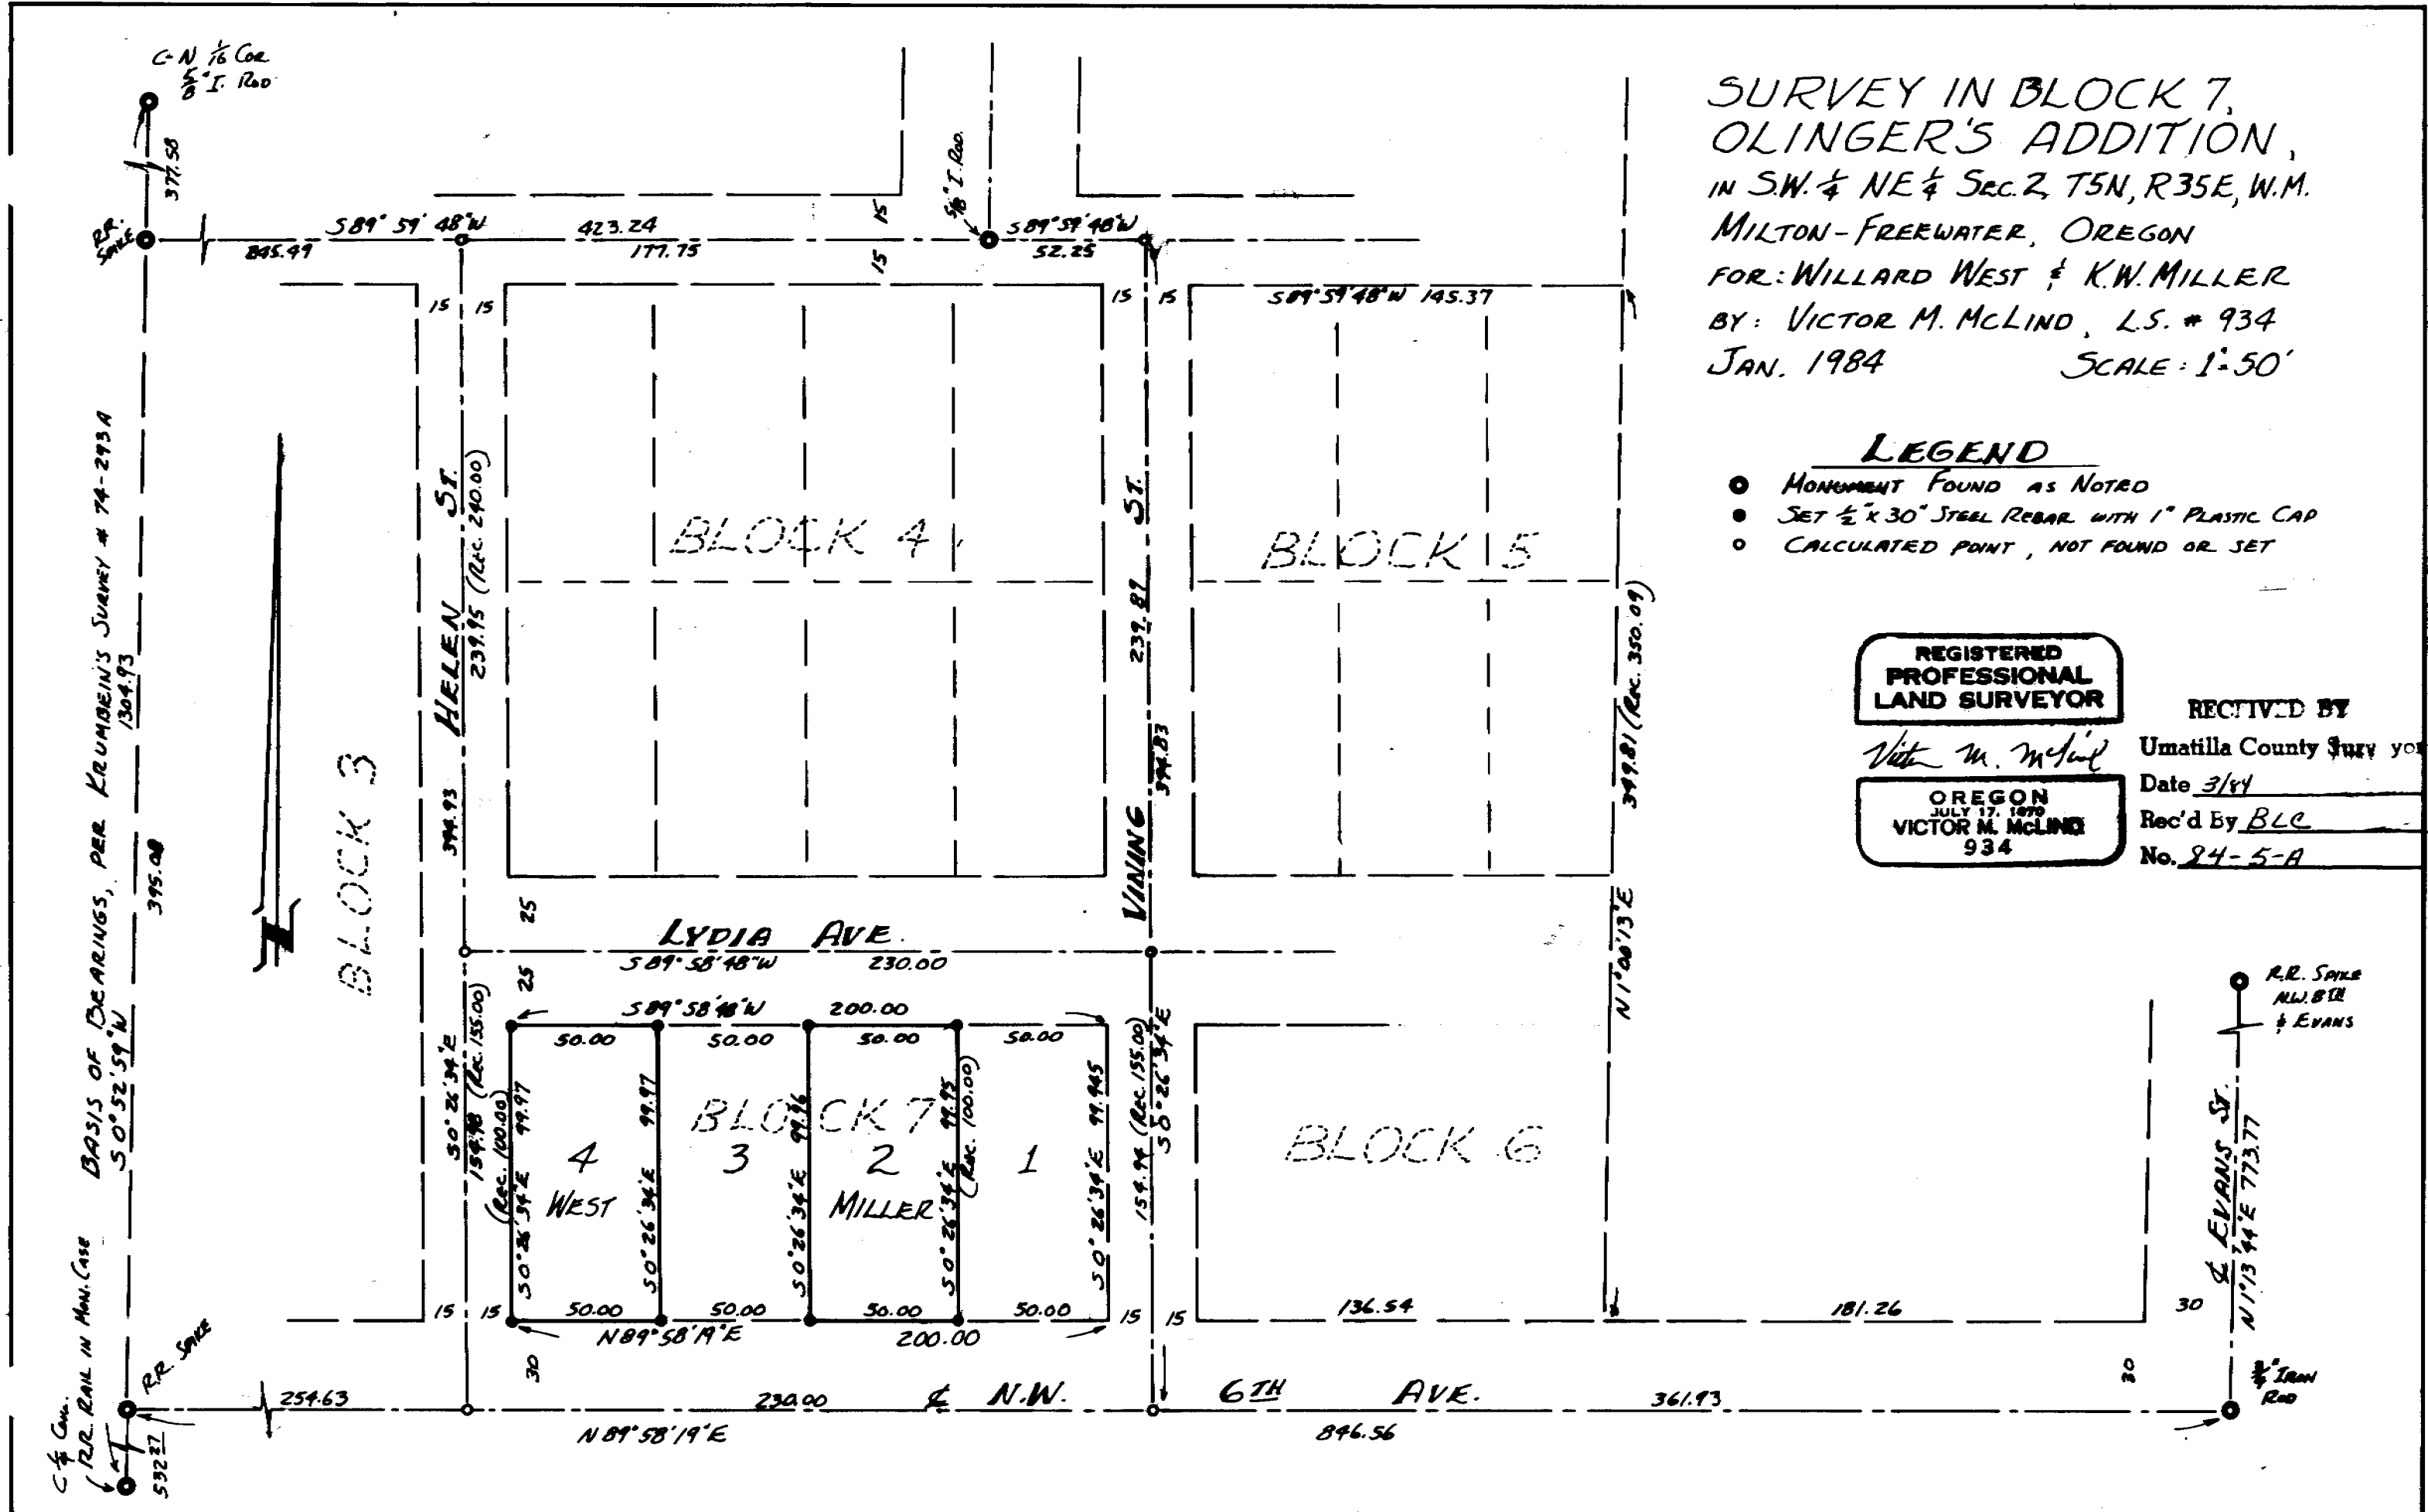

84-5-A

NARRATIVE OF SURVEY

SURVEYED BY: Victor M. McLind, Route 3, Box 2, Milton-Freewater, OR 97862

SURVEYED FOR: John & Jayne Mauer and Rodger Hicks

DATE OF SURVEY: January 25, 1984

LOCATION: SW $\frac{1}{4}$  NE $\frac{1}{4}$  Sec. 24, T 6 N, R 35 E

MONUMENTS FOUND: As shown on plat. These include a monument set by Lommasson as per his survey for John Starlin, and 2 monuments set by Jon Cole during his survey for H. D. Matthews in 1971.

MONUMENTS SET:  $\frac{1}{2}$ " X 30" Steel re-bar with 1" plastic caps mkd. L.S. 934, as shown on plat.

PURPOSE OF SURVEY: To split off a 4 acre tract for land partition

COMMENTS: I found no survey of record for the North line of the property to be divided. Deed records indicate this line to be parallel to and 430 feet southerly from the North line of Tax Lot 400. (see deeds 278-7 and 279-493) I used Lommasson's pin and his distance North from the C-N 1/16 corner to locate the North line of Tax Lot 400. The North line of the property I surveyed as located by the above method closely follows an old established fence line. I used found monuments set by Jon Cole during his survey for Matthews in 1971 to establish the South line of the property I Surveyed. This line also follows an old established fence line. The only evidence I found for the East line, which is the N-S centerline of the northeast quarter of section 24, was an old fence line.

REGISTERED  
PROFESSIONAL  
LAND SURVEYOR

*Victor M. McLind*

OREGON  
JULY 17, 1970  
VICTOR M. McLIND  
934