


5N2B17BD

5000

6-1

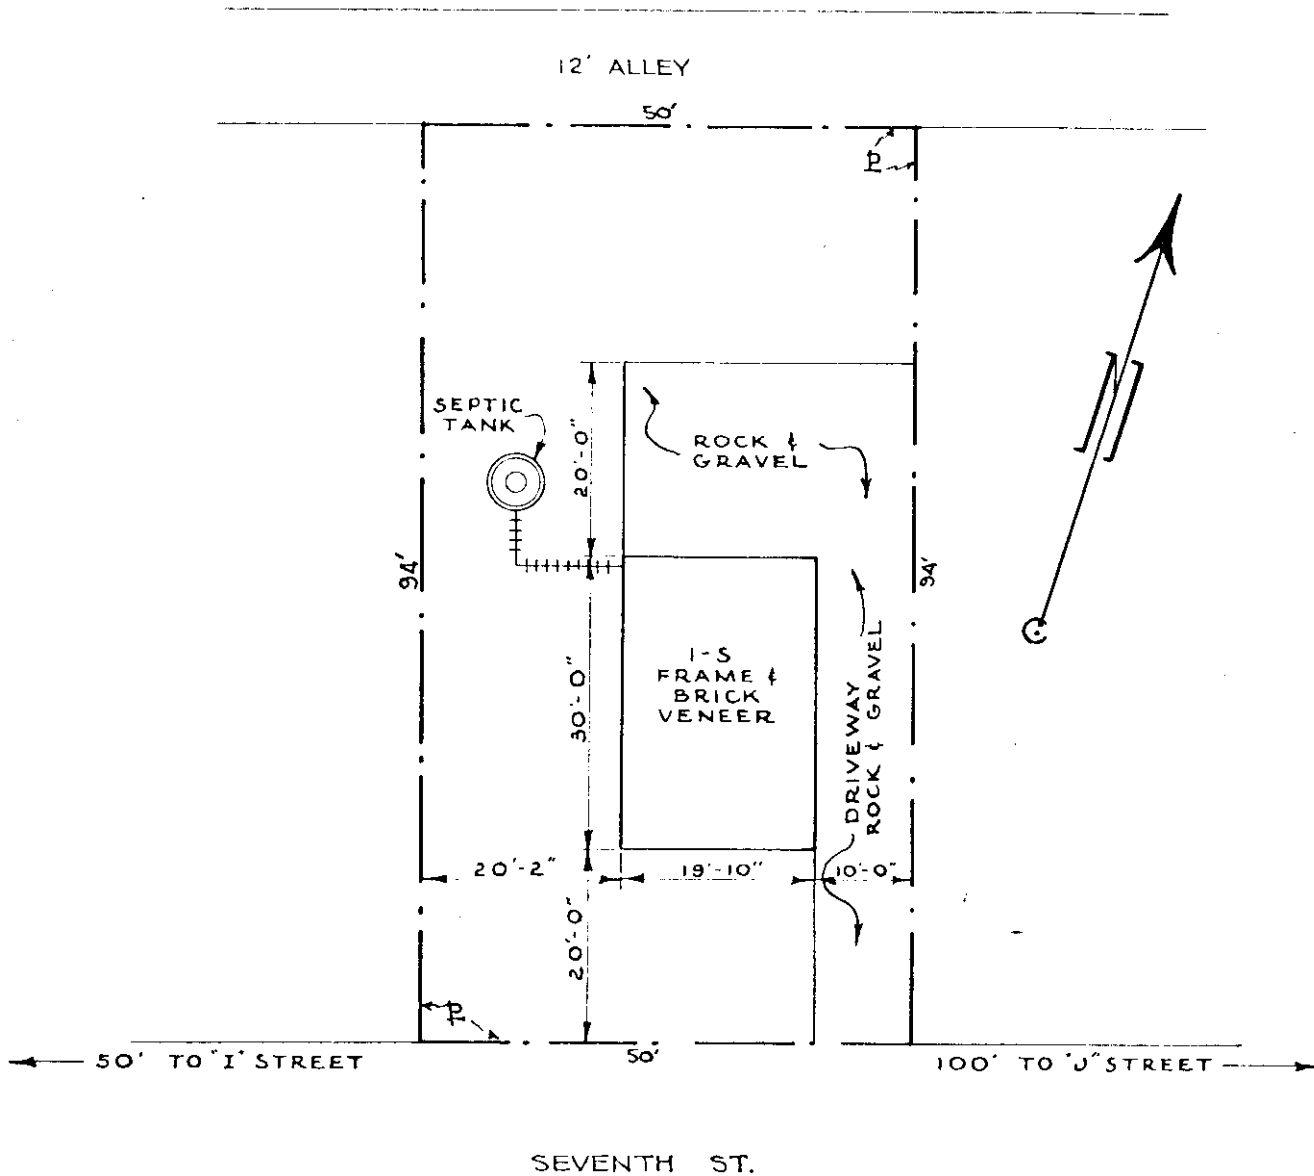

CENTRAL ASSESS.

1/1/47

ORDER 24-1947.

UMATILLA COUNTY
 Umatilla R.E. #300
 (Formerly Umatilla R.E. #1)

LOT 7- BLK.87 WARDWELL'S ADDITION.

R.E. #4 300

| | | |
|--|----------|----------------------|
| THE PACIFIC TEL. & TEL. CO. OFFICE OF CHIEF ENGINEER PORTLAND | DRAWING | AO-208 |
| | SCALE | 1" = 20' |
| COMMUNITY DIAL OFFICE UMATILLA, OREGON SITE PLAN | DRAWN BY | K.C. |
| | APPROVED | <i>M.C. Peterson</i> |

RE-300

RECEIVED BY

Umatilla County Surveyor

Date 1985

Rec'd By bc

No. 85-10-A