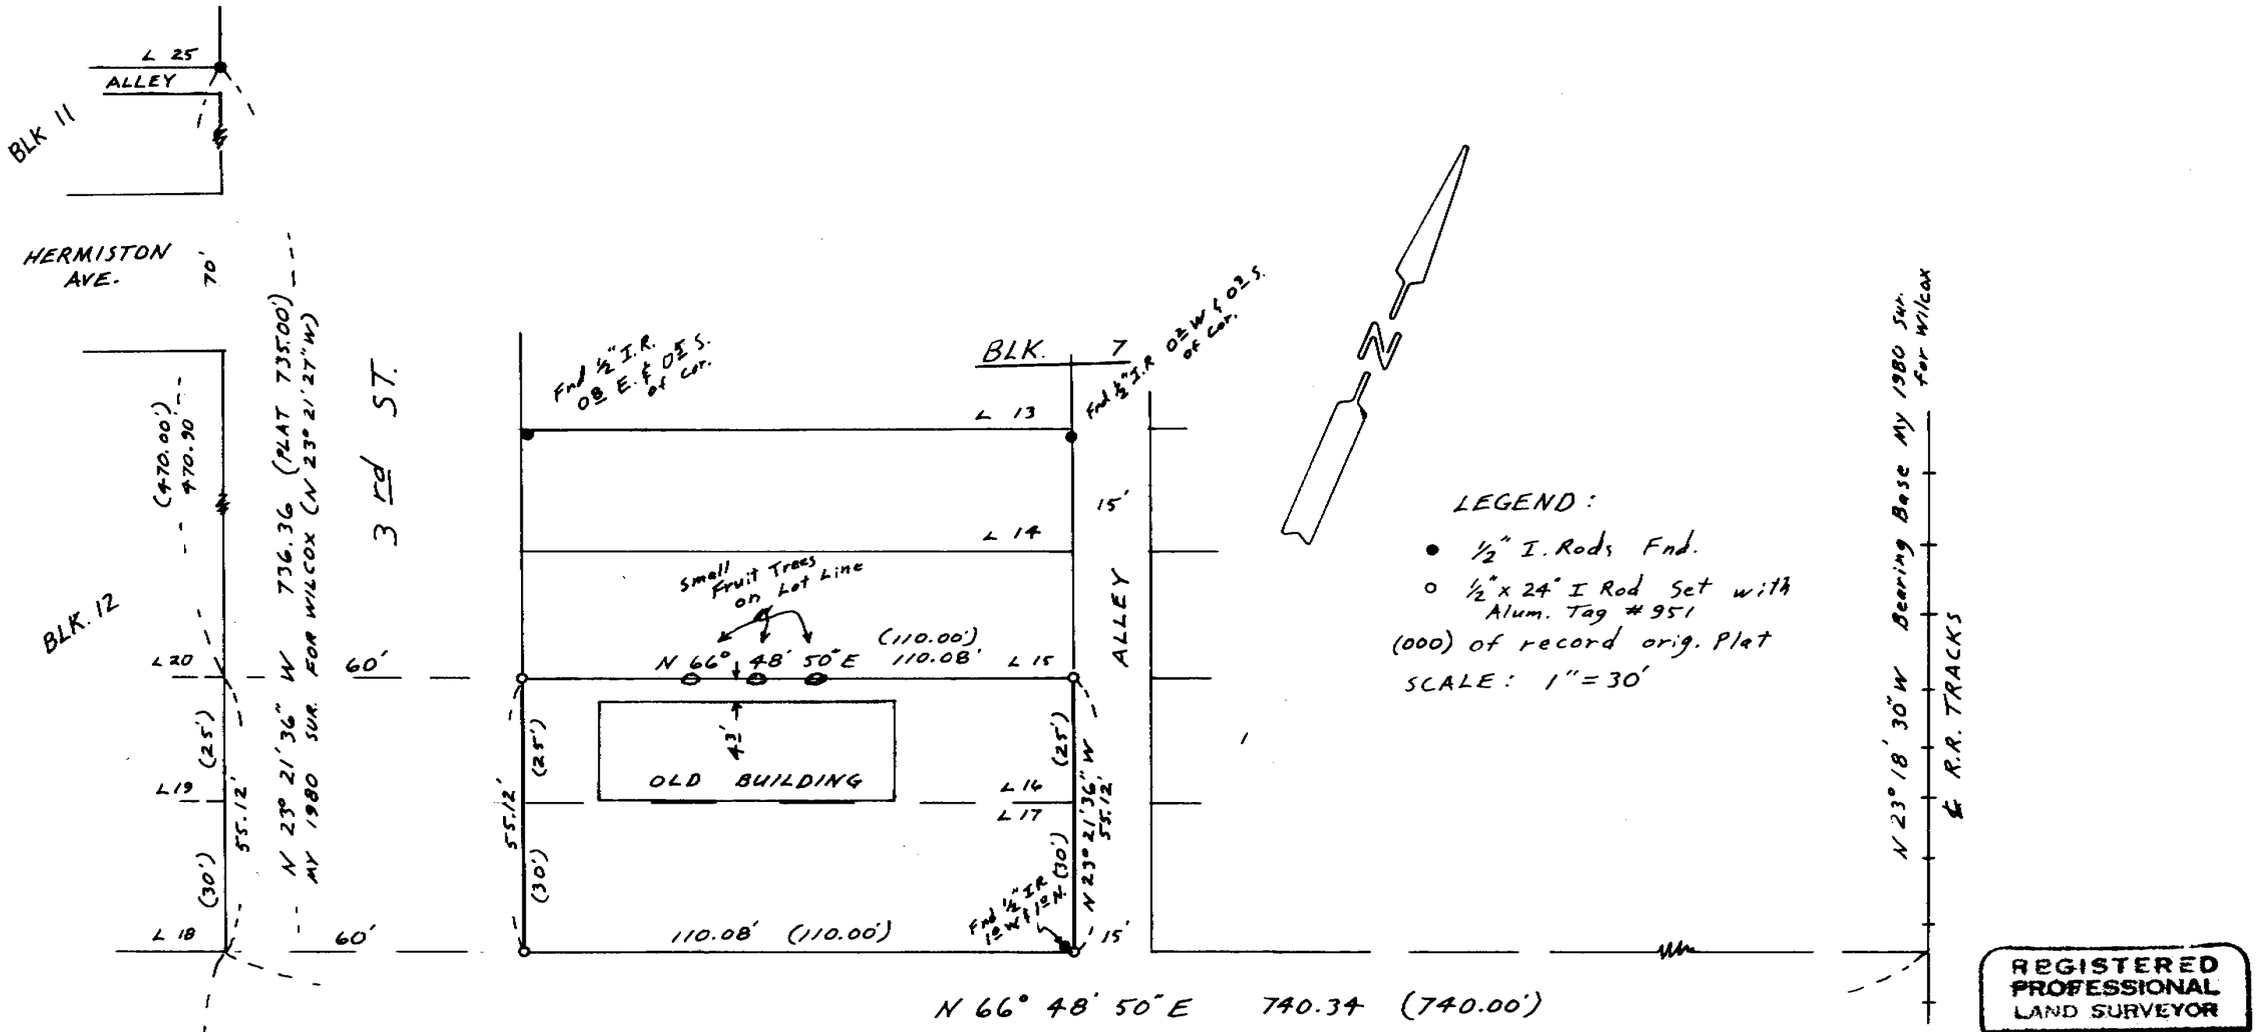

LEGEND:

- ● ½" I. Rods Fnd.
- o ½" x 24" I Rod Set with Alum. Tag # 951

(000) of record orig. Plat

SCALE: 1" = 30'

REGISTERED PROFESSIONAL LAND SURVEYOR

G. Dennis Edwards

OREGON
JULY 16, 1971
G. DENNIS EDWARDS
951

RECEIVED BY
Umatilla County Surveyor
Date 10-28-86
Rec'd By KA
No. 86-123-A

NARRATIVE:

The purpose of this survey is to set the 4 corners of Lots 16 & 17, BLK. 7, ORIG. TOWN OF HERMISTON, Sec. 10, T4N, R28E, W.M., so a new building can be built.

The distance between the 3 Iron rods Fnd. in BLK. 7 do not correspond to the original distances by approximately one foot so I did not use any of them. I used the same E-W Bearing as on my 1980 sur. for J. Wilcox in BLK 7. That is very near a 90° ∠ to 3rd st. which is on the Original Plat.

SURVEY FOR COLUMBIA BUILDING SYSTEMS
IN BLK. 7, ORIG. TOWN OF HERMISTON
IN SE ¼ Sec. 10, T4N, R28E, W.M.
UMATILLA COUNTY, OREGON
10/22/86 Job # 58610039

EDWARDS SURVEYING P.O. Box 763
567-3336 HERMISTON, OREGON

86-123-A