


REGISTERED  
PROFESSIONAL  
LAND SURVEYOR

*G. Dennis Edwards*

OREGON  
JULY 18, 1971  
G. DENNIS EDWARDS  
951

NARRATIVE: The purpose of this survey is to stake the east line of Loper's property which is recorded on R. 141, P 1401, Umatilla County Deed Records. Said line is parallel with and 550 feet West of the N-S  $\perp$  of the NE 1/4 of Sec. 4.

In a survey for Red Leonard in May 1974, Don Staebler subdivided Section 4. I used Staebler's subdivision in my 1982 (Revised 1985) survey for Sjoren and my 1984 sur. for Vickery.

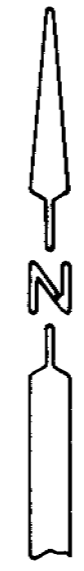

SCALE: 1" = 100'

- Monuments Found
- 1/2" x 24" Rebar Set with Alum. Tag # 951
- x—x— Wire fence with wood posts

RECEIVED BY  
Umatilla County Surveyor  
11-87  
Rodney *RA*  
No. 87-58-A

BEARING BASE IS Bearing of  $S44^{\circ}35'33''W$  1854.86' from SE 1/4 cor. to S 1/4 Cor. (a nail over 1/2" I.R.) which was computed from my 1982 (Rev. 1985) survey for Sjoren.

SE 1/4 Cor. found 1/2" Rebar set by me in 1982 (Rev. 1985) sur. for Sjoren

SURVEY FOR DAVE LOPER  
% Phil DeFilippis  
IN NE 1/4 Sec. 4, T4N, R28E, W.M.,  
UMATILLA COUNTY, OREGON  
8/13/87 Job # 58708038  
EDWARDS SURVEYING P.O. Box 763  
567-3336 HERMISTON, OREGON  
87-58-A