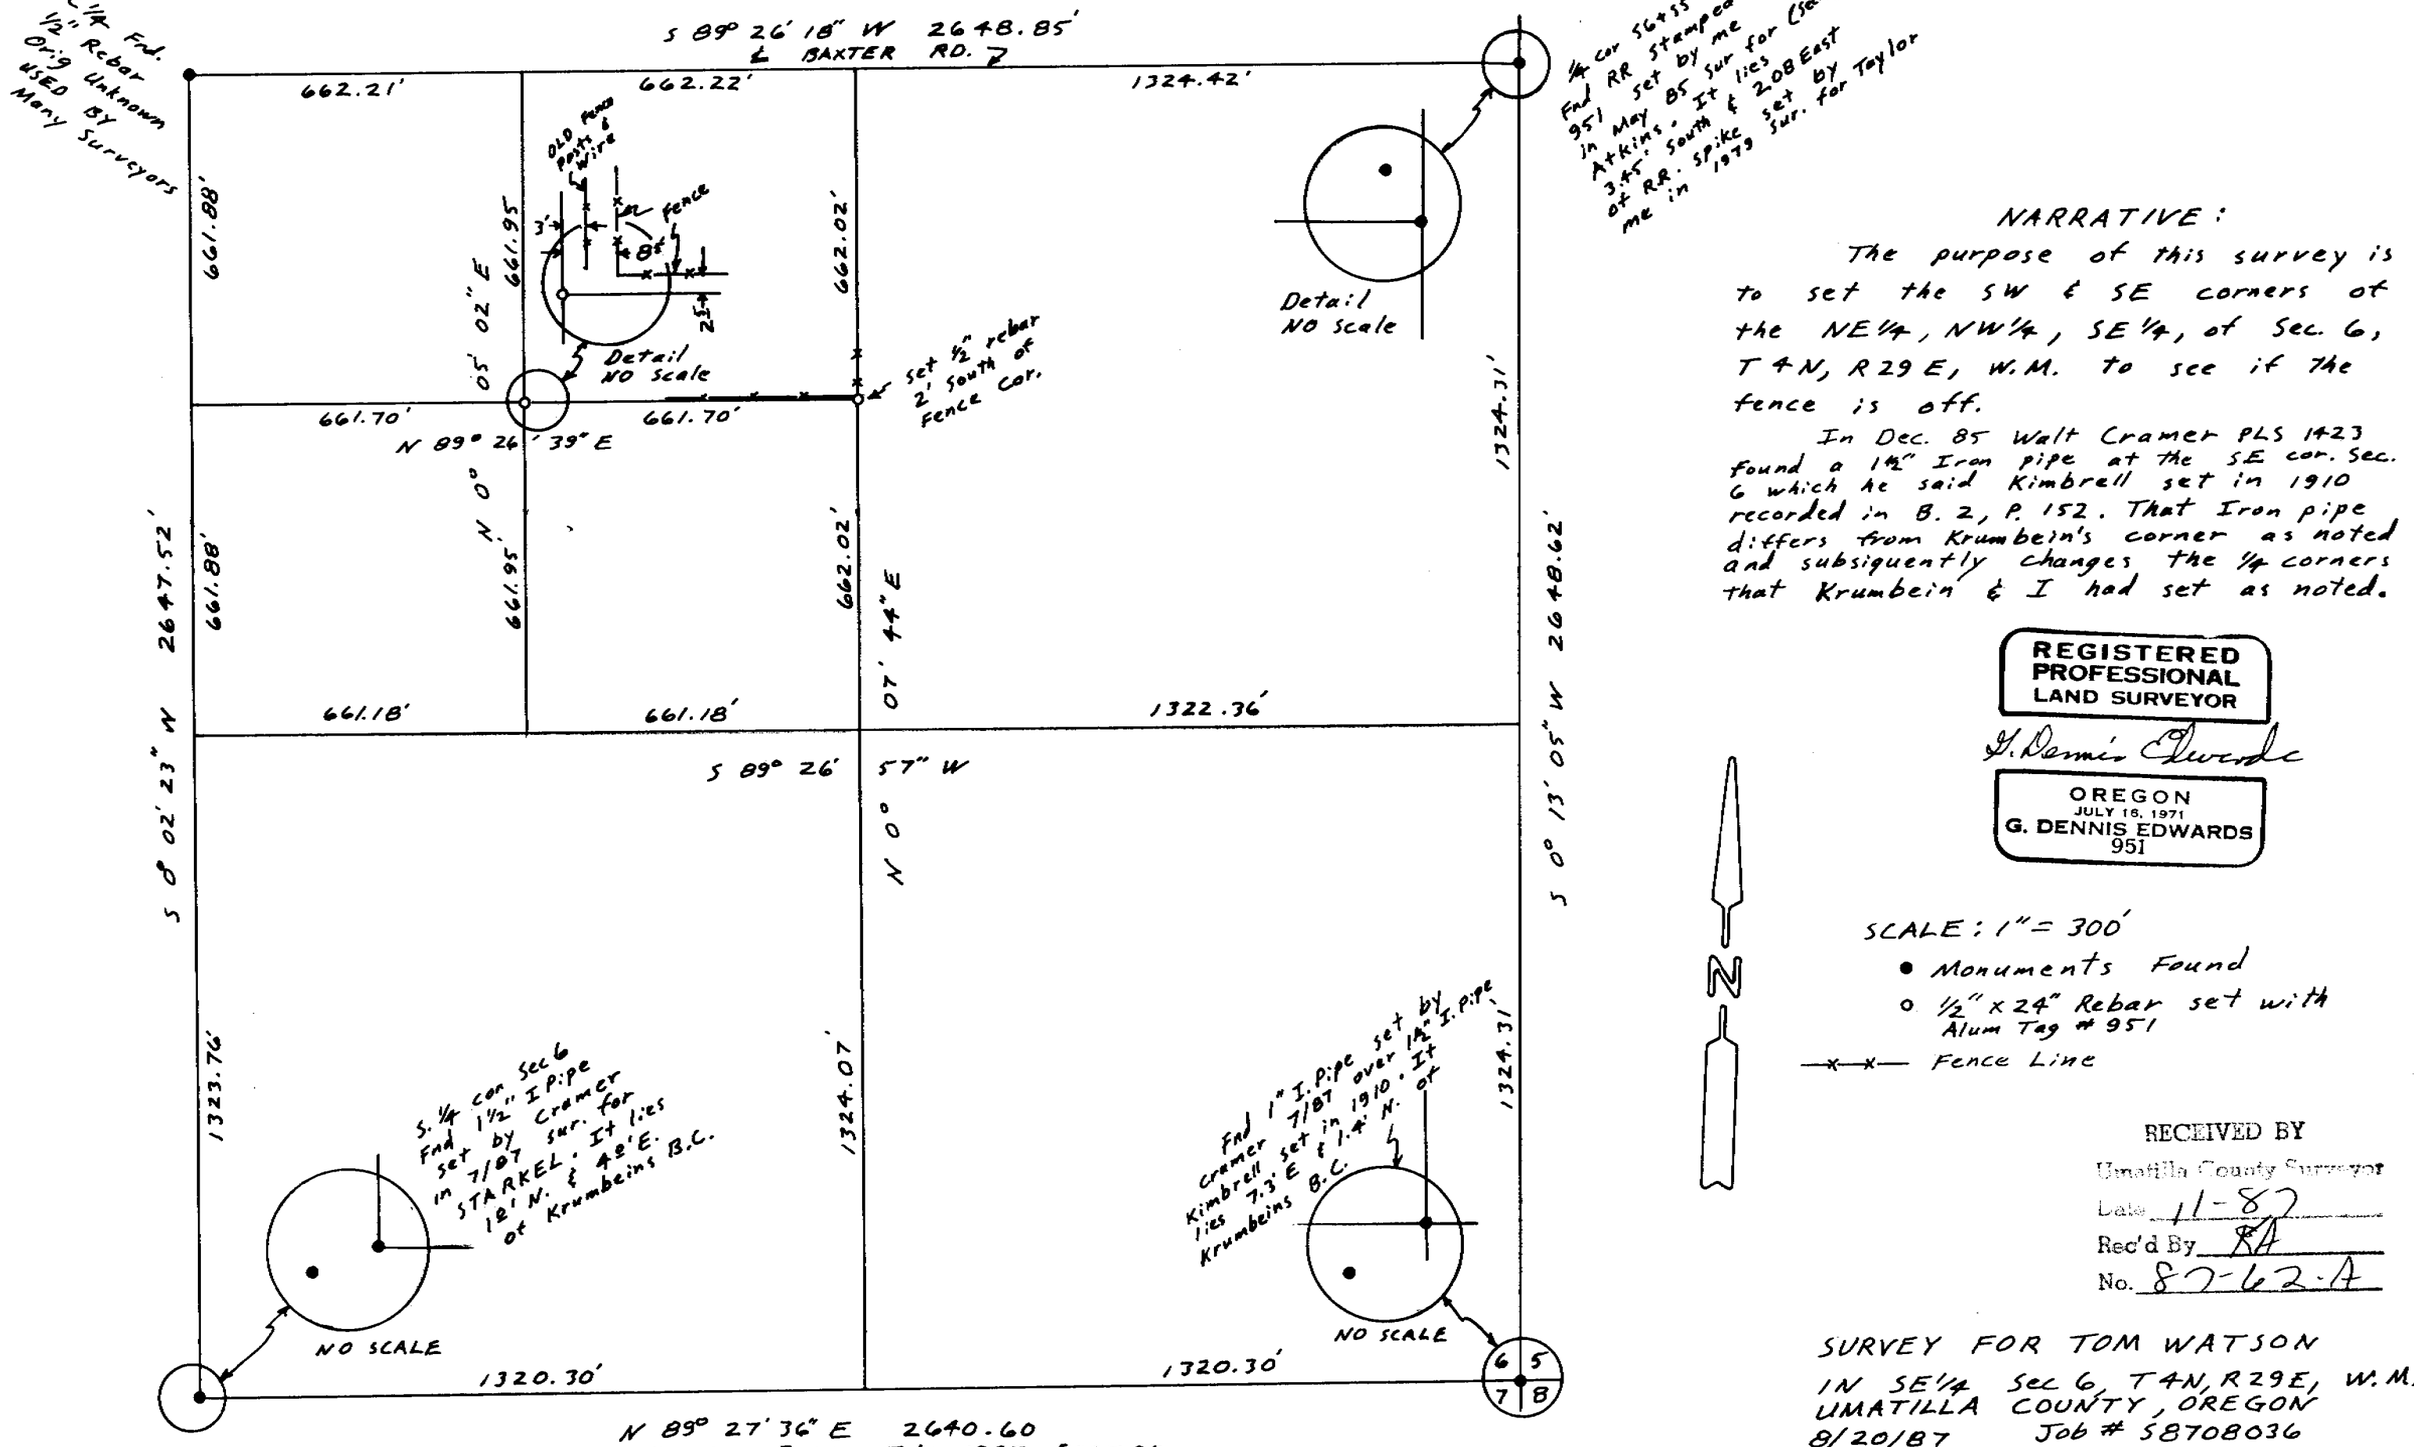

NARRATIVE:

The purpose of this survey is to set the SW & SE corners of the NE1/4, NW1/4, SE1/4, of Sec. 6, T 4N, R 29 E, W.M. to see if the fence is off.

In Dec. 85 Walt Cramer PLS 1423 found a 1½" Iron pipe at the S.E cor. Sec. 6 which he said Kimbrell set in 1910 recorded in B. 2, P. 152. That Iron pipe differs from Krumbein's corner as noted and subsiquently changes the 1/4 corners that Krumbein & I had set as noted.

REGISTERED PROFESSIONAL LAND SURVEYOR

G. Dennis Edwards

OREGON
JULY 16, 1971
G. DENNIS EDWARDS
951

SCALE: 1" = 300'

- ● Monuments Found
- o ½" x 24" Rebar set with Alum Tag # 951
- —x—x— Fence Line

RECEIVED BY
Umatilla County Surveyor
Date 11-87
Rec'd By RA
No. 87-62-A

SURVEY FOR TOM WATSON
IN SE1/4 Sec 6, T4N, R29E, W.M.
UMATILLA COUNTY, OREGON
8/20/87 Job # 58708036
EDWARDS SURVEYING PO Box 763
567-3336 HERMISTON, OREGON

87-62-A