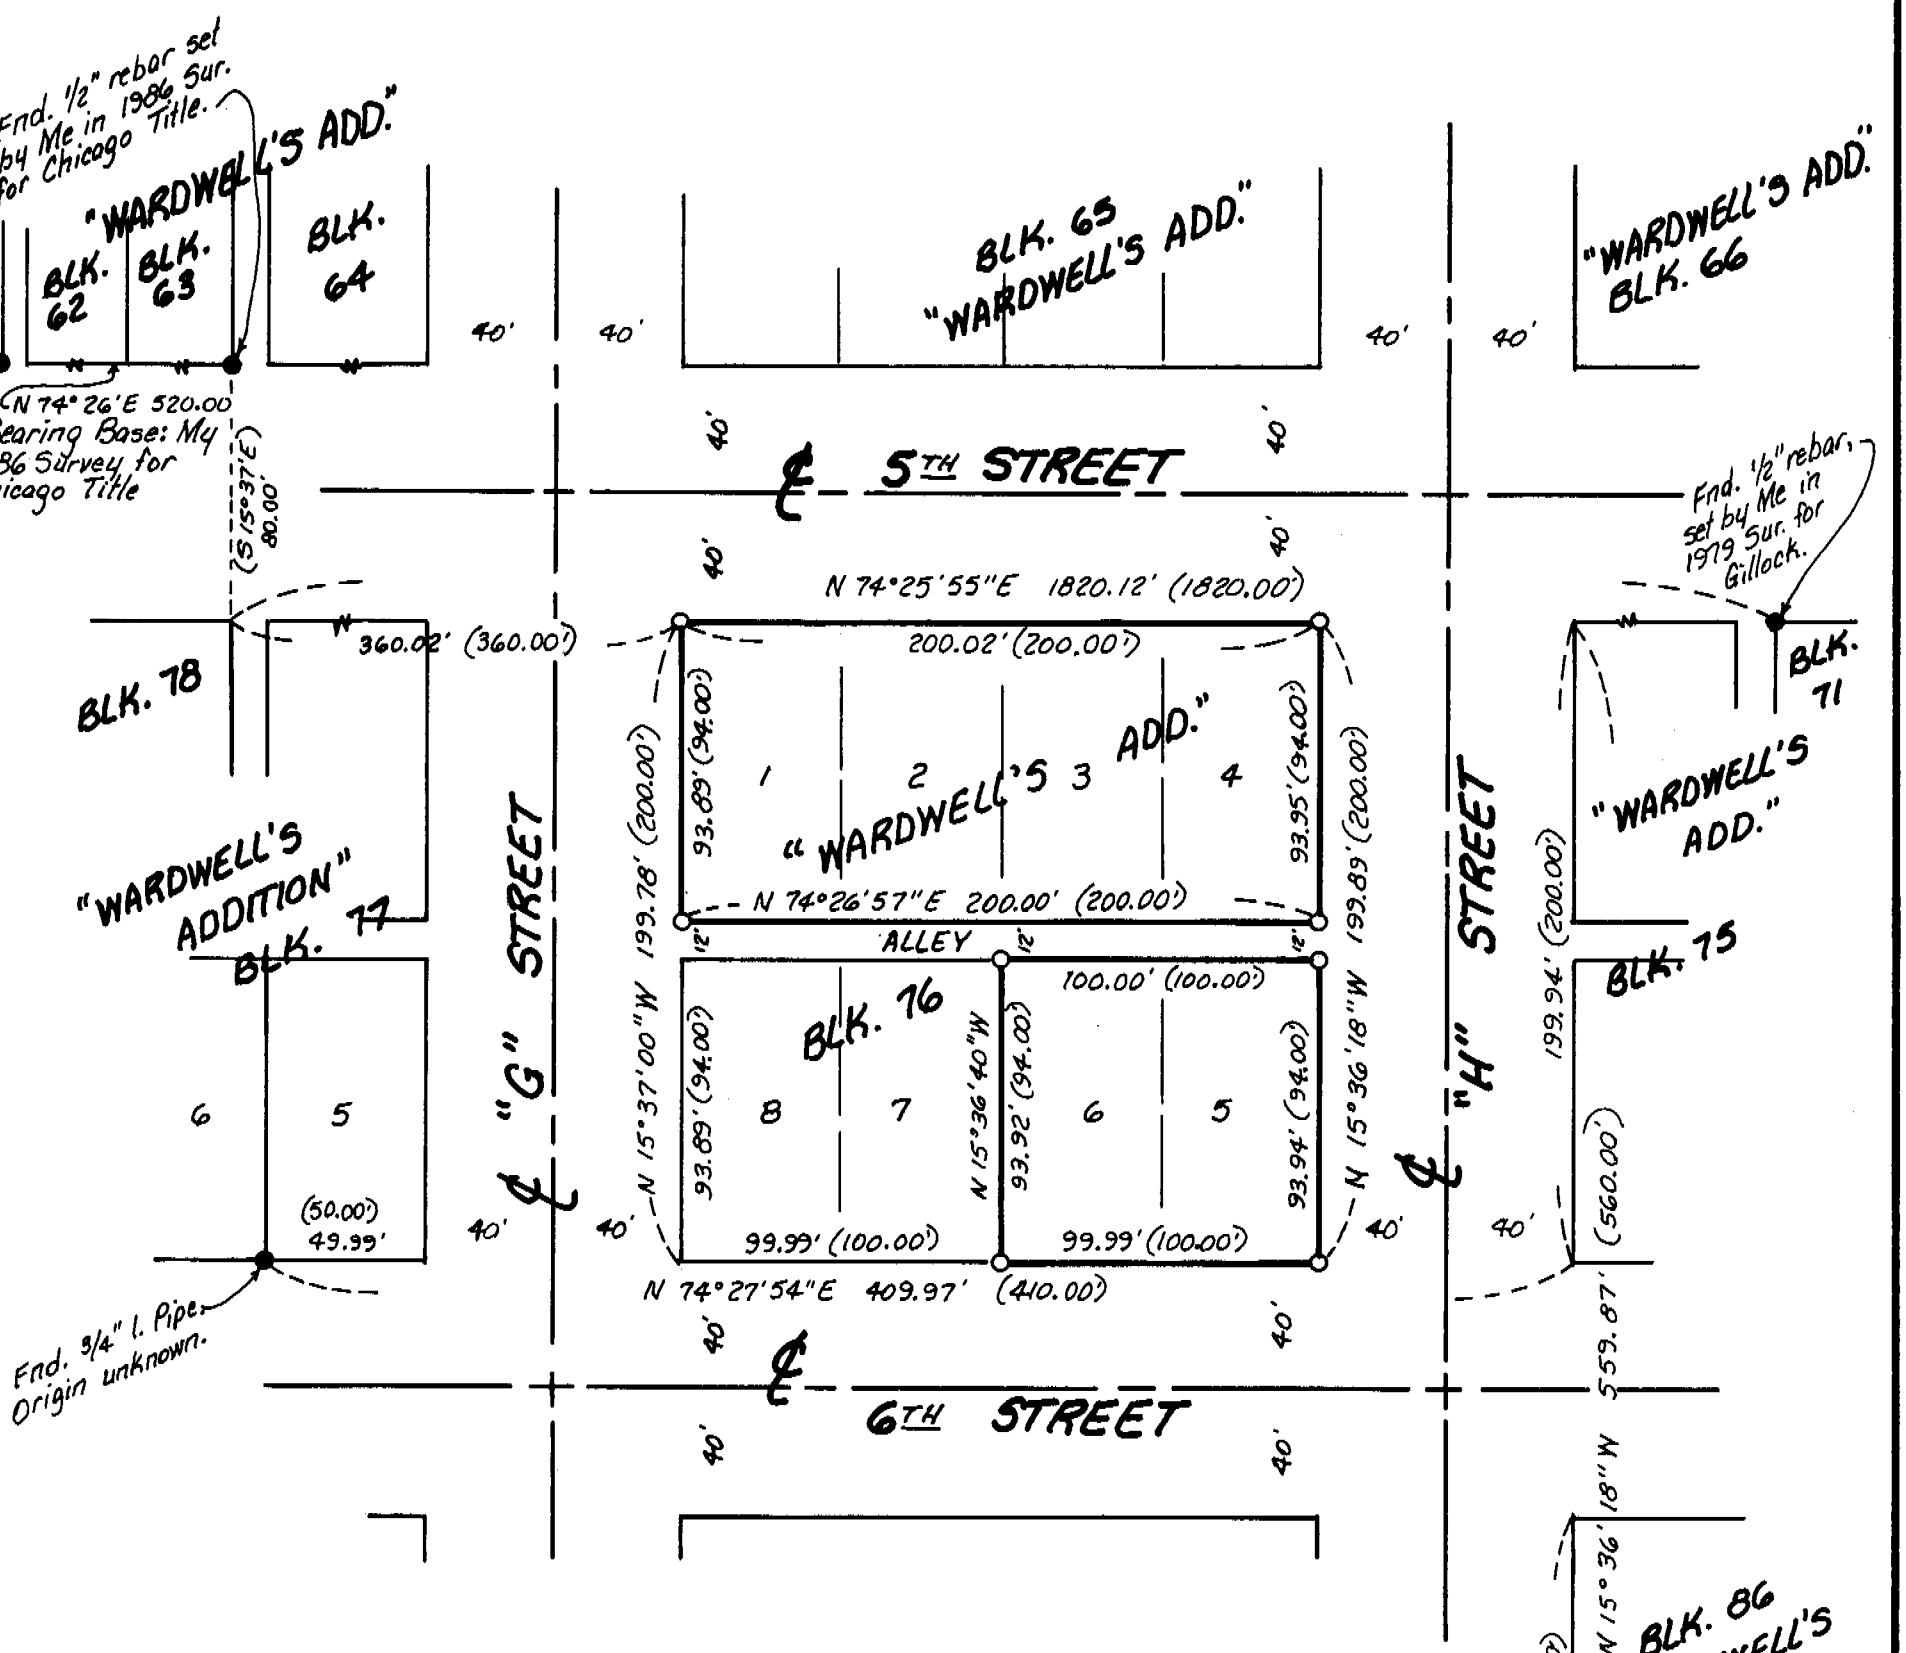

NARRATIVE:

The purpose of this survey is to stake the corners of Lots 1 through 6, Block 76, in preparation for a replat which will allow the construction of two businesses.

RECEIVED BY
Umatilla County Surveyor
Date 10-94
Rec'd By KK
No. 94-150-A
94-150-A

LEGEND:

- ● Found monuments, as noted.
- ○ Set 5/8" x 30" rebar with plastic cap #951.
- (000) of Record. Plat of "WARDWELL'S ADDITION."

Survey for BURK and MATTISON
In Block 76, "WARDWELL'S ADDITION" to City of Umatilla, Umatilla County, Oregon
In NW 1/4 Section 17, T5N, R28E, W.M.
6/2/94 Job #S9406063
Edwards Surveying P.O. Box 763
503-567-3336 Hermiston, OR. 97838

94-150-A