


SCALE 1"=100'

LEGEND:

- FOUND 5/8" REBAR WITH PLASTIC CAP # 951. PARTITION PLAT 1995-15
- FOUND 1/2" REBAR ME 1976 SURVEY FOR THOMPSON.
- ◆ FOUND 5/8" REBAR WITH PLASTIC CAP # 951. 1995 SURVEY FOR TOM ABLE.
- SET A 5/8" REBAR WITH PLASTIC CAP # 951.

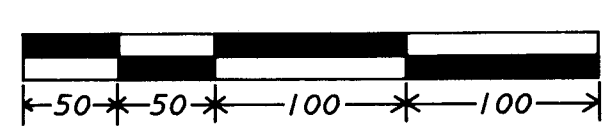

SCALE 1"=100'

NARRATIVE:

THE PURPOSE OF THIS SURVEY IS TO DO A BOUNDARY LINE ADJUSTMENT OF PARCELS 2 AND 3 OF PARTITION PLAT #1995-15 FOR A PENDING SALE OF THE SOUTHERLY 3.33 ACRES OF PARCEL 2.

I SURVEYED THESE PARCELS IN MY #1995-15 PARTITION PLAT FOR TOM ABLE, JR. AND THE BEARINGS AND THIS SURVEY ARE BASED ON THAT PARTITION PLAT.

RECEIVED BY
 Umatilla County Surveyor
 Date 3-96
 Rec'd by KK
 No. 96-46-A

REGISTERED
 PROFESSIONAL
 LAND SURVEYOR

G. Dennis Edwards

OREGON
 JULY 16, 1971
 G. DENNIS EDWARDS
 951

RENEWS 12/31/97

SURVEY FOR:

TOM ABLE JR.

LOCATED IN THE SW 1/4 OF SECTION 13.
 T 4 N. R 28 E. WM.. UMATILLA COUNTY. OR.

EDWARDS SURVEYING
 PO BOX 763
 HERMISTON. OR 97838

2/21/1996
 JOB NO S9503031-D
 541-567-3336

96-46-A