

**SURVEYOR'S NARRATIVE:**

THE PURPOSE OF THIS SURVEY IS TO REVISE THE SURVEY I DID FOR AUSTIN ON 6/03/96 TO MAKE THE EAST LOT LARGER THAN 9000 SQUARE FEET.

REGISTERED  
PROFESSIONAL  
LAND SURVEYOR

*G. Dennis Edwards*


OREGON  
JULY 16, 1971  
G. DENNIS EDWARDS  
951  
RENEWS 12/31/97

**LEGEND:**

- ▼ SET 5/8" X 30" REBAR WITH A PLASTIC CAP MARKED LS 951.
- FND. 5/8" REBAR. ME 6/03/96 FOR AUSTIN.
- FND. MONUMENTS AS NOTED.

( 000 ) OF RECORD. DEEDS.

SCALE  
1"=60'

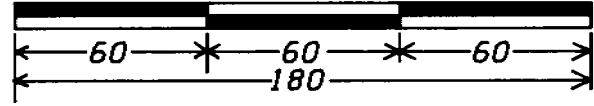

RECEIVED BY

Umatilla County Surveyor  
Date: 7-96  
By: KK  
No. 96-118-A

SURVEY FOR:  
**ELAINE AUSTIN**  
LOCATED IN THE SW 1/4, NW 1/4 OF  
SECTION 11, T 4 N, R 28 E, VM,  
UMATILLA COUNTY, OREGON.  
EDWARDS SURVEYING      JOB NO. S9604073-A  
PO BOX 763                      6/20/96  
HERMISTON, OR. 97838      541-567-3336

96-118-A