


NARRATIVE:

The purpose of this survey is to stake the following described property so the lease holder can build a fence along the property line. I retraced Robinett's 1948 survey of "CHARLES TRACTS" from his monuments which I found, to establish the corners of this tract.
DESCRIPTION: All of Lots 2 and 3, and Lot 1, excepting the West 100.00 feet, Block 2, "CHARLES TRACTS," lying in Section 27, T5N, R28E, W.M., Umatilla County, Oregon.

REGISTERED PROFESSIONAL LAND SURVEYOR
G. Dennis Edwards
 OREGON
 JULY 16, 1971
 G. DENNIS EDWARDS
 951
 RENEWS 12/31/97

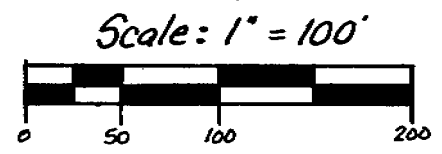

LEGEND:

- Found monuments, as noted.
- Set 5/8" x 30" rebar with plastic cap #951.
- ⊙ Set 5/8" x 30" rebar with plastic cap #951 over Found 5/8" Iron Rod set by Robinett in 1948.
- (000) of Record. 1948 survey of "CHARLES TRACTS" Umatilla County Surveyor by E. Robinett.

RECEIVED BY
 Umatilla County Surveyor
 Date 10-2-97
 Rec'd by KK
 No. 97-203-A

Survey for CHARLIE KIK
 In Block 2, "CHARLES TRACTS"
 In SW 1/4, SE 1/4 of Section 27, T5N, R28E, W.M.,
 Umatilla County, Oregon
 10/1/97 Job #59709230
 Edwards Surveying P.O. Box 763
 541-567-3336 Hermiston, Oregon 97838

97-203-A