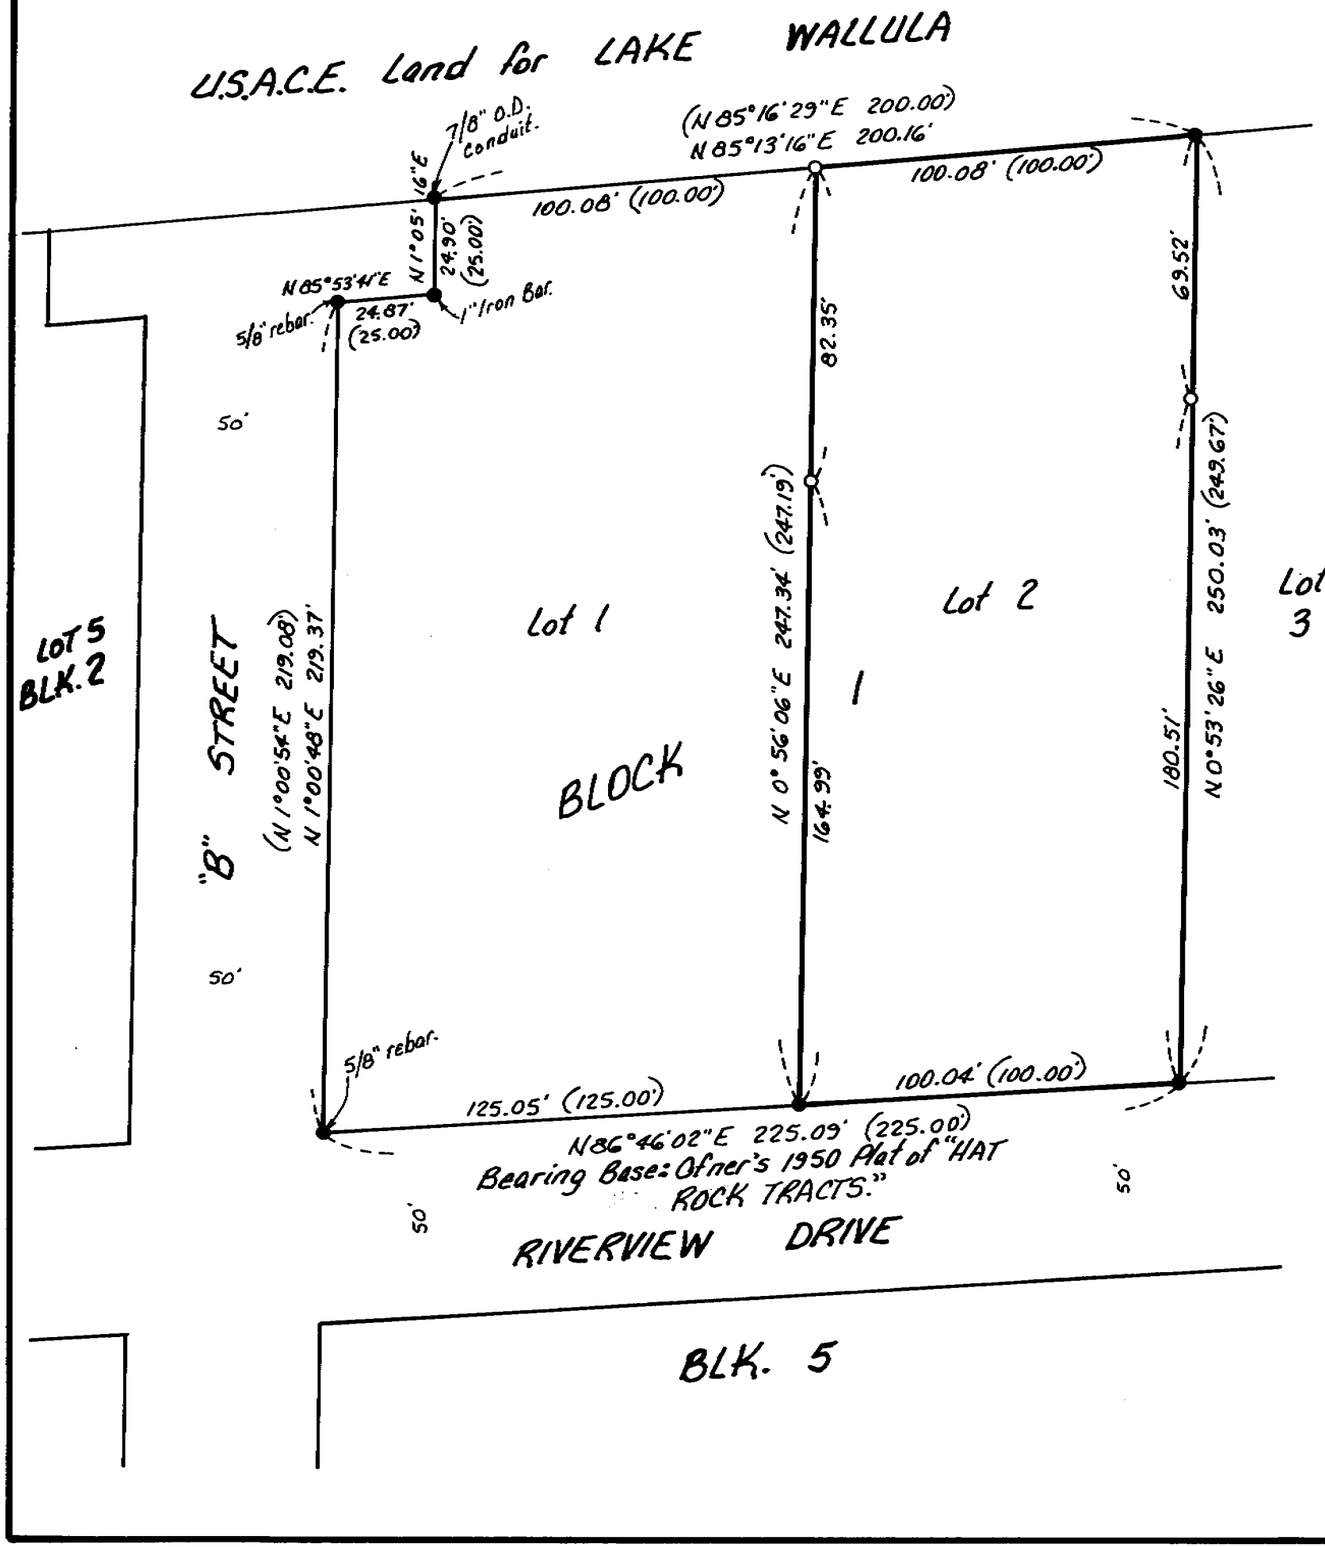

NARRATIVE:

The purpose of this survey is to locate or set the corners of Lot 2, Block 1, "HAT ROCK TRACTS" and to set monuments on the East and West sides thereof which are intervisible to the lot corners so a house can be sited.

I set the missing Northwest corner by single proportion between the Northwest corner of Lot 1 and the Northeast corner of Lot 2.

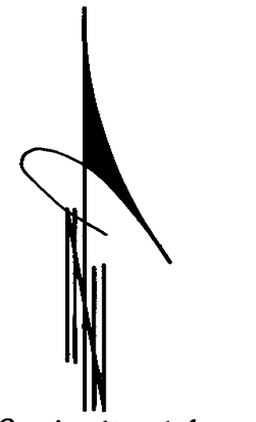

Scale: 1" = 40'

0 20 40 80

REGISTERED PROFESSIONAL LAND SURVEYOR

G. Dennis Edwards

OREGON
JULY 16, 1971
G. DENNIS EDWARDS
951
RENEWS 12/31/97

LEGEND:

- ● Found monuments set in 1950 by Ofner 1/2" Iron Rod, unless noted otherwise.
- ○ Set 5/8" x 30" rebar with plastic cap "951."
- (000) of Record. Plat of "HAT ROCK TRACTS" by Frank Ofner in 1950.

RECEIVED BY
Umatilla County Surveyor
Date 12-97
Rec'd By KK
No. 97-253-A

Survey for MICHAEL WARNER
On Lot 2, Block 1, "HAT ROCK TRACTS,"
In the NE¼ Section 15, T5N, R29E, W.M.,
Umatilla County, Oregon
12/10/97 Job# 59712280
Edwards Surveying P.O. Box 763
541-567-3336 Hermiston, Oregon 97838

97-253-A