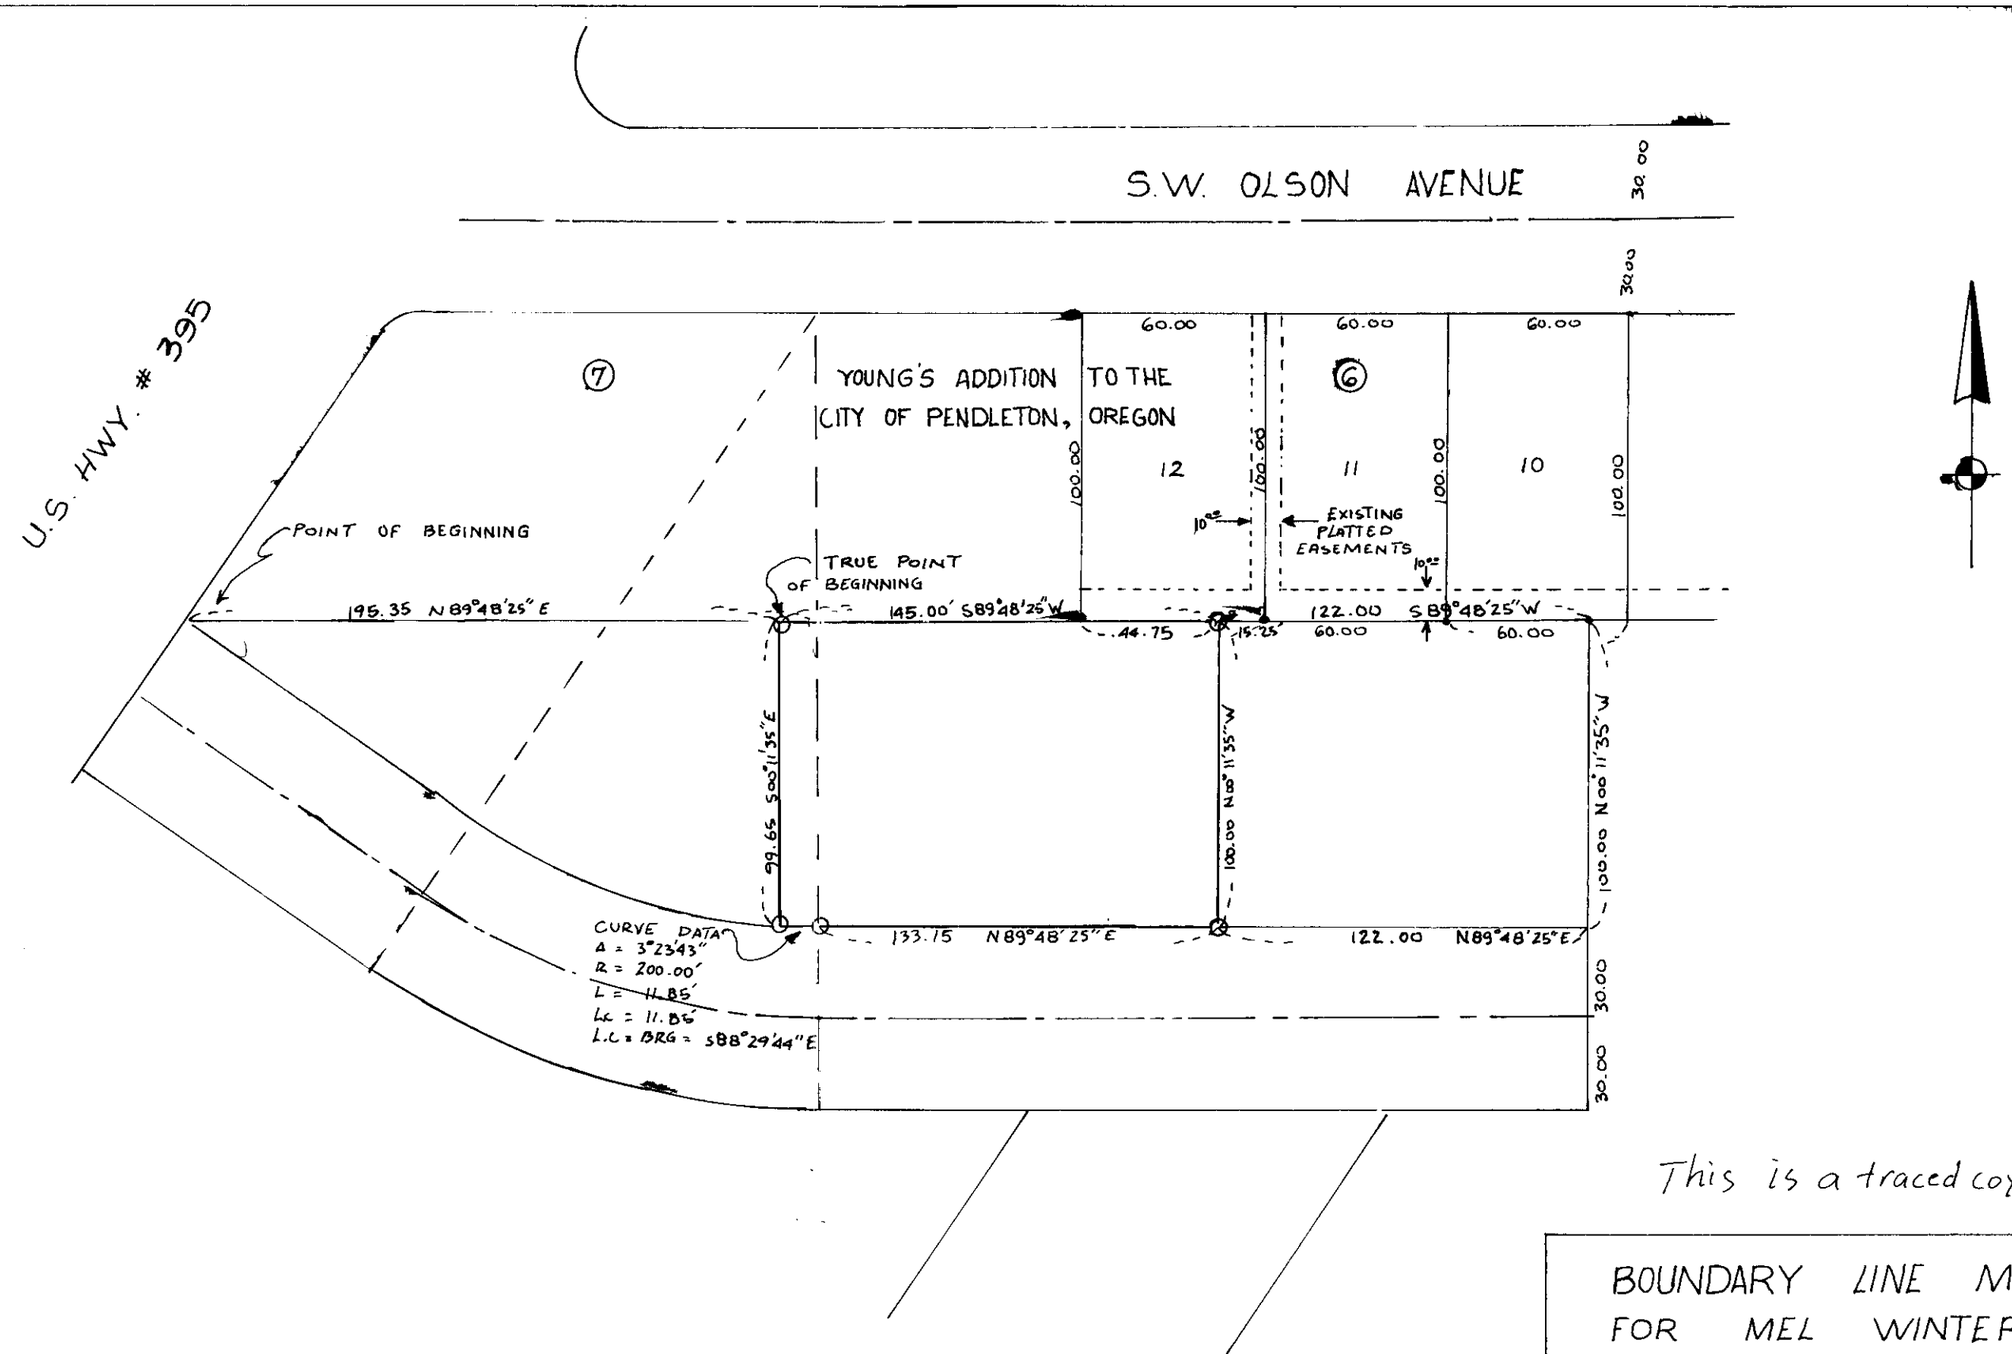

This is a traced copy

BOUNDARY LINE MAP
FOR MEL WINTER

DRAWN BY: KWC	DATE: 1-8-68	SCALE 1" = 50'

DONALD L. STAEBLER
CONSULTING ENGINEER
P.O. BOX 91
PENDLETON OREGON

99-179-A

T2N R32 Sec. 16DA

99-179-A