

NARRATIVE:

THE PURPOSE OF THIS SURVEY IS TO STAKE THE EAST HALF OF THE NE 1/4 OF THE NE 1/4 OF THE NW 1/4 OF SECTION 11 TO SEE HOW THE FENCES LIE IN RELATION TO THE DEED LINES. SAID PARCEL IS DESCRIBED AS TRACT TWO IN A DEED TO DALLAS AND JUNE HACKLER RECORDED ON REEL 226, PAGE 166, UMATILLA COUNTY DEED RECORDS.

I SET THE SOUTHWEST CORNER OF THIS TRACT IN A SURVEY (IN PROGRESS) FOR AL DEDRICK FOR A PARCEL WHICH LIES TO THE WEST OF THIS TRACT. I BASED THE BEARINGS AND THE SURVEY ON THAT SURVEY FOR DEDRICK


REGISTERED
PROFESSIONAL
LAND SURVEYOR

G. Dennis Edwards

OREGON
JULY 16, 1971
G. DENNIS EDWARDS
9 5 1
RENEWS 12/31/2001



SCALE: 1"=100'

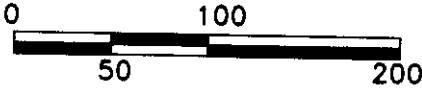

LEGEND:

- FOUND MONUMENTS AS NOTED
- SET 5/8"X30" IRON REBAR WITH PLASTIC CAP #951
- ⊙ COMPUTED LOCATION

SURVEY FOR DAVID HACKLER
IN NE 1/4, NW 1/4, SEC. 11, T 4 N, R 28 E,
W.M., UMATILLA COUNTY, OREGON
2/20/01 JOB# S0102021-A
EDWARDS SURVEYING P.O. BOX 763
HERMISTON, OREGON 97838
-567-3336
DRAWN BY NJF

RECEIVED BY
Umatilla County Surveyor

Date 3-01
Rec'd by JK
01-41-A

01-41-A