


BLOCK 183

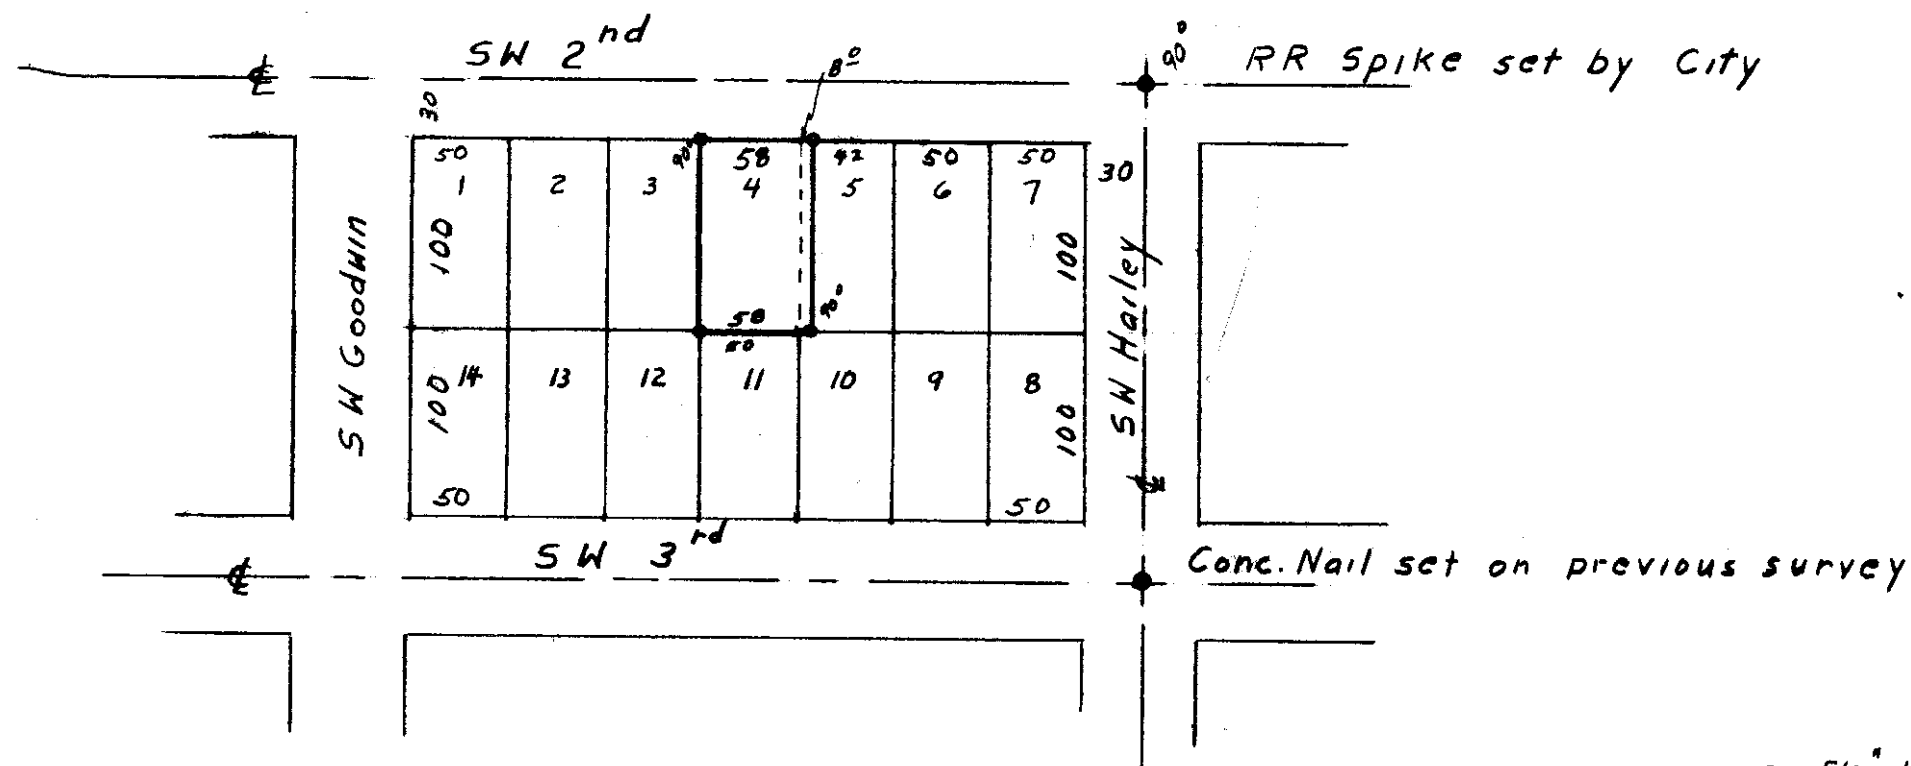

- 5/8" Iron Pin set
- Mon as noted

NA RRATIVES:

PURPOSE OF SURVEY WAS TO SET PROPERTY CORNERS FOR LOT 4 AND WESTERLY 8.0 FEET OF LOT 5, BLOCK 183 OF RESERVATION ADDITION TO THE TOWN OF PENDELTON.

I FOUND A RAILROAD SPIKE SET BY THE CITY OF PENDELTON AT THE CENTER LINE INTERSECTION OF S. W. SECOND AND HAILEY AND A CONCRETE NAIL SET BY THE WAYNE HARRIS CO. AT THE CENTERLINE INTERSECTION OF S. W. THIRD AND HAILEY; DISTANCE DIVIATION WAS NEGLIGIBLE BETWEEN THESE POINTS.

I TURNED A 90° ANGLE, MEASURED CALL DISTANCE AND SET TWO TEMPORARY POINTS ON CENTER LINE. I TURNED RIGHT ANGLES AND SET IRON PINS AT RECORDED DISTANCES.

03-144-A

**WAYNE HARRIS CO. INC.**

---

SURVEY FOR: MARALYN HORNE

LOCATION: BLOCK 183 RESERVATION ADD.

DATE 12-19-85  
 SCALE 1" = 100  
 DRN BY *wor*

CHECK BY *wor*  
 FILE 1712  
 JOB  
 DRNG NO. 96-17A

2032 10AD

03-144-A