


03-157-A

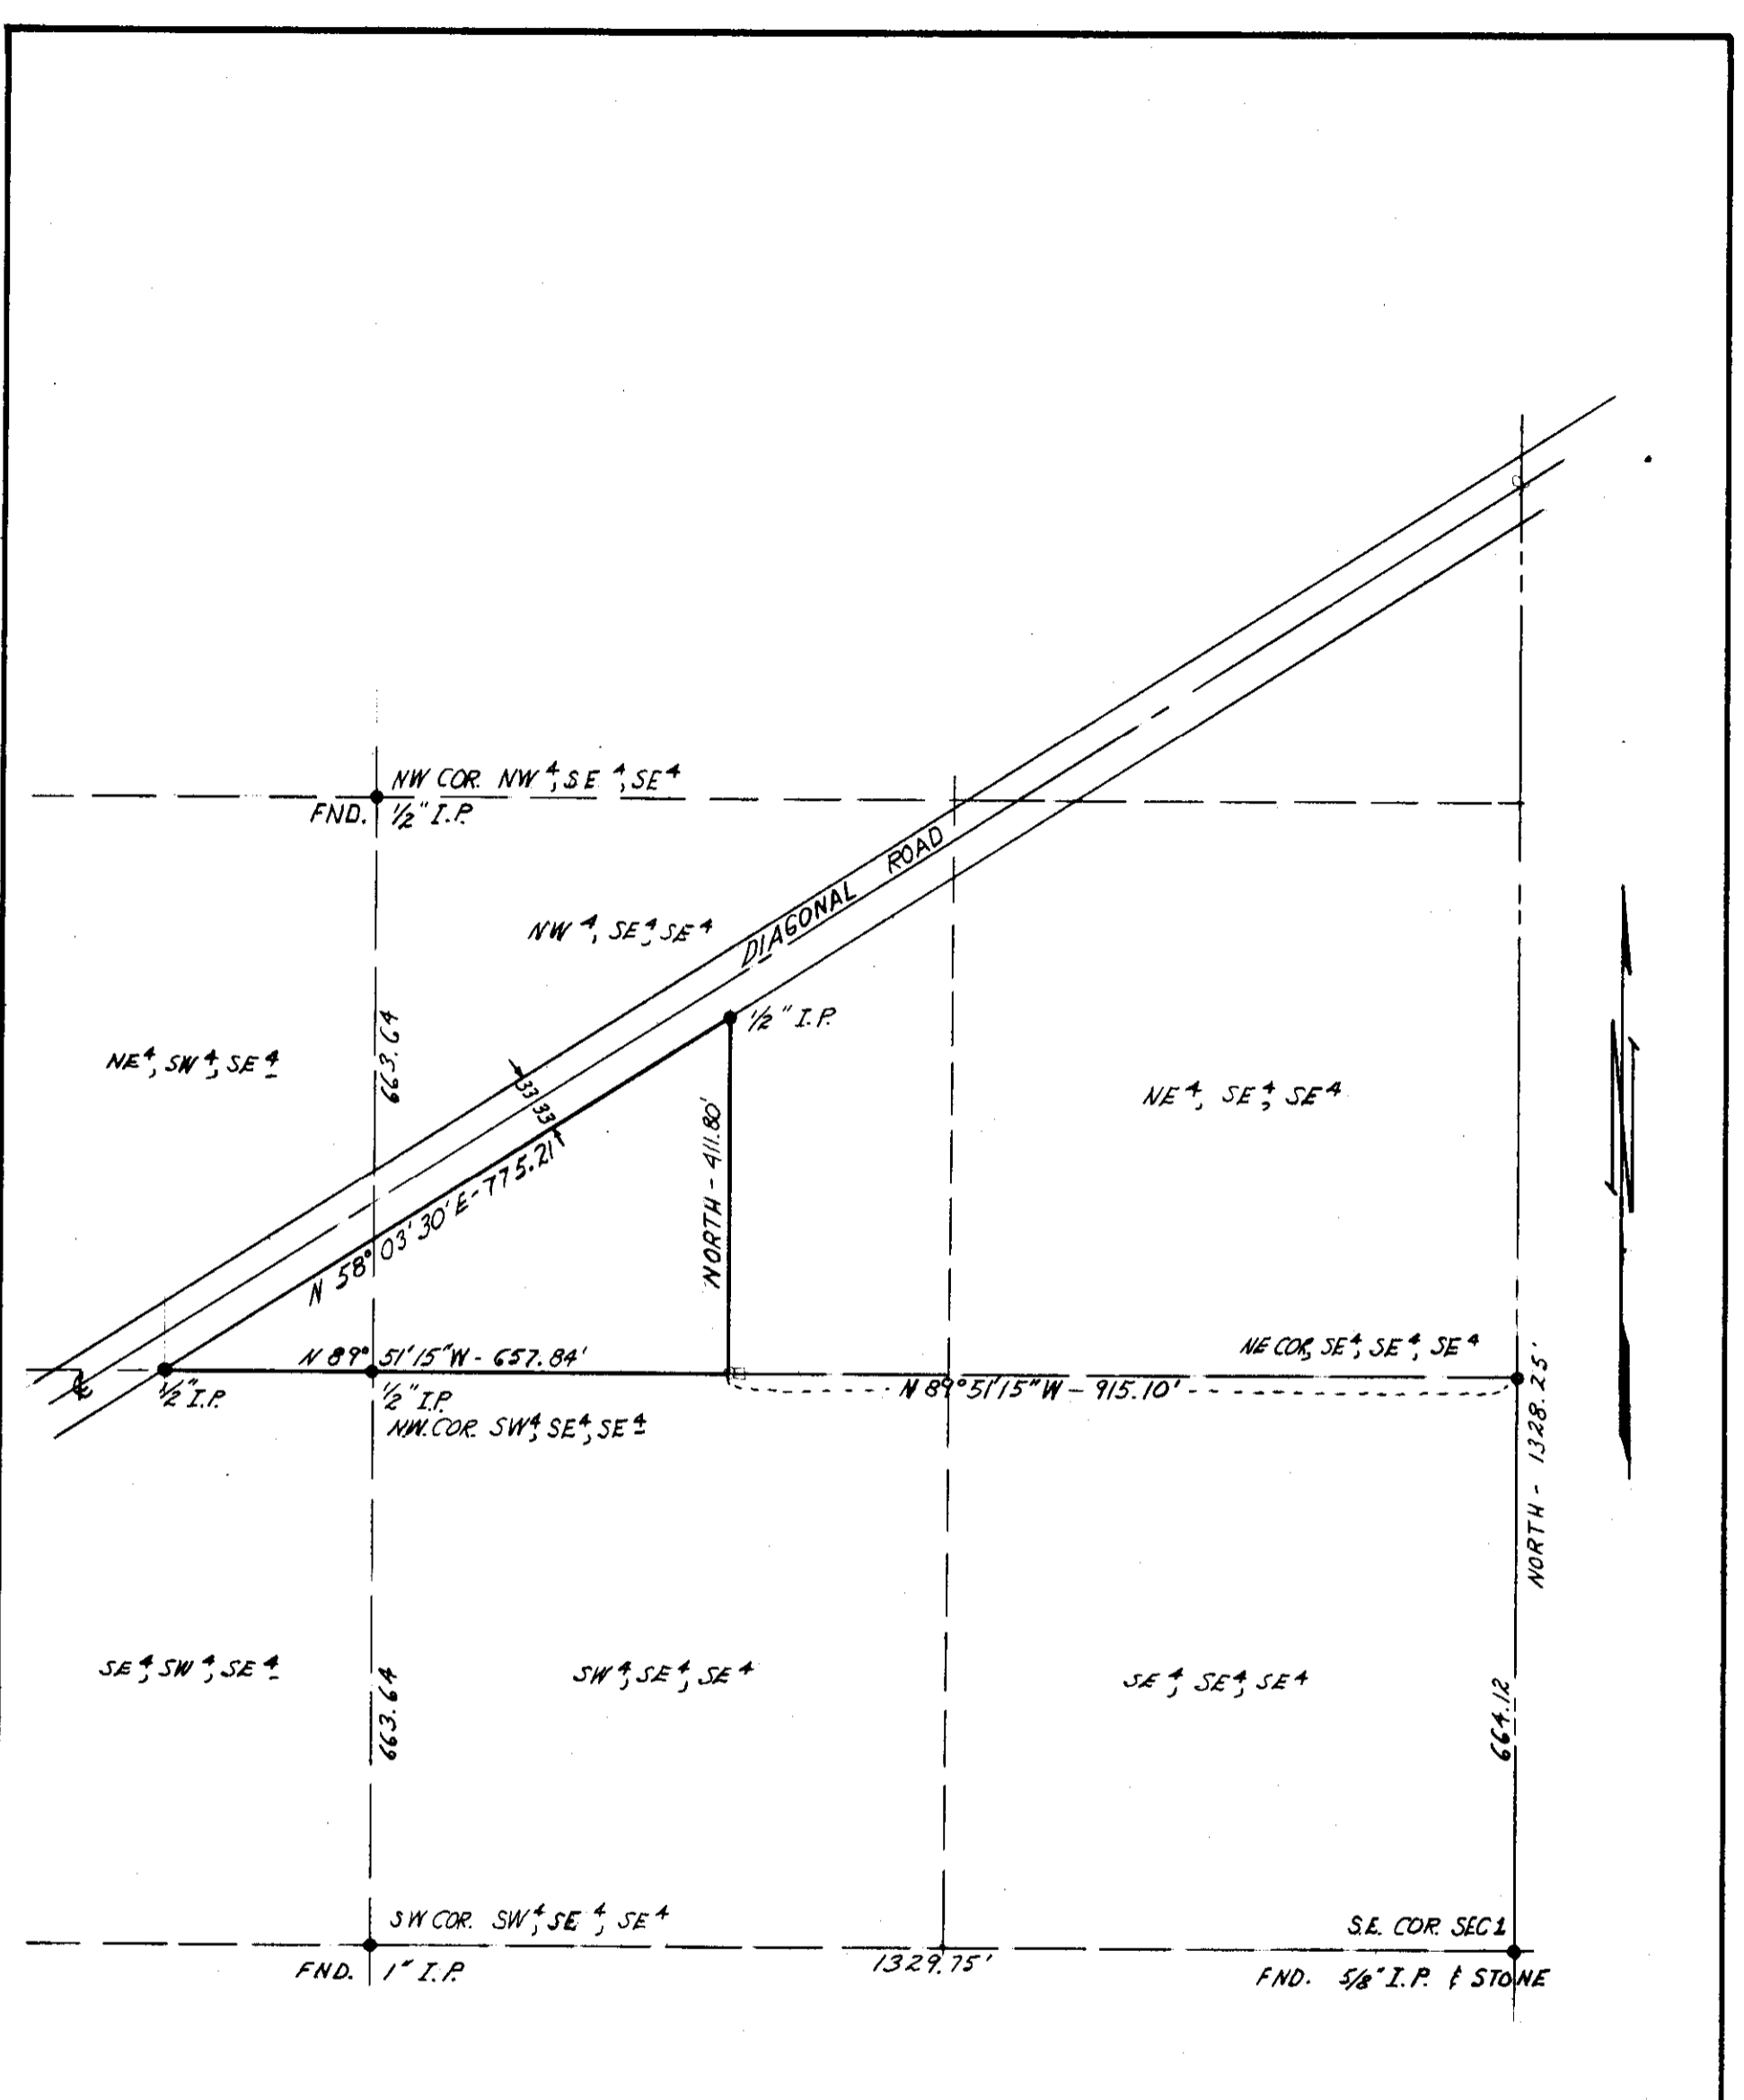

03-157-A

REGISTERED
OREGON
LAND SURVEYOR

Wayne O. Harris

MAY 6, 1955
WAYNE O. HARRIS
346

HAYES AND HARRIS			
SURVEY FOR			
BALLENGER REAL ESTATE			
A PARCEL OF LAND IN THE			
NE $1/4$, SW $1/4$, SE $1/4$ & NW $1/4$, SE $1/4$, SE $1/4$			
SEC. 1, T. 4 N., R. 28 E., W.M.			
SCALE	DATE	DRAWN BY	DRW NO
1"=200'	7/7/59	RWC	59-79A