




NOTE:

ALL BEARINGS ARE TRUE.
 THEY ARE BASED ON THE
 AVERAGE OF TWO SOLAR OBSERVATIONS
 TAKEN ON DECEMBER 13, 1967.

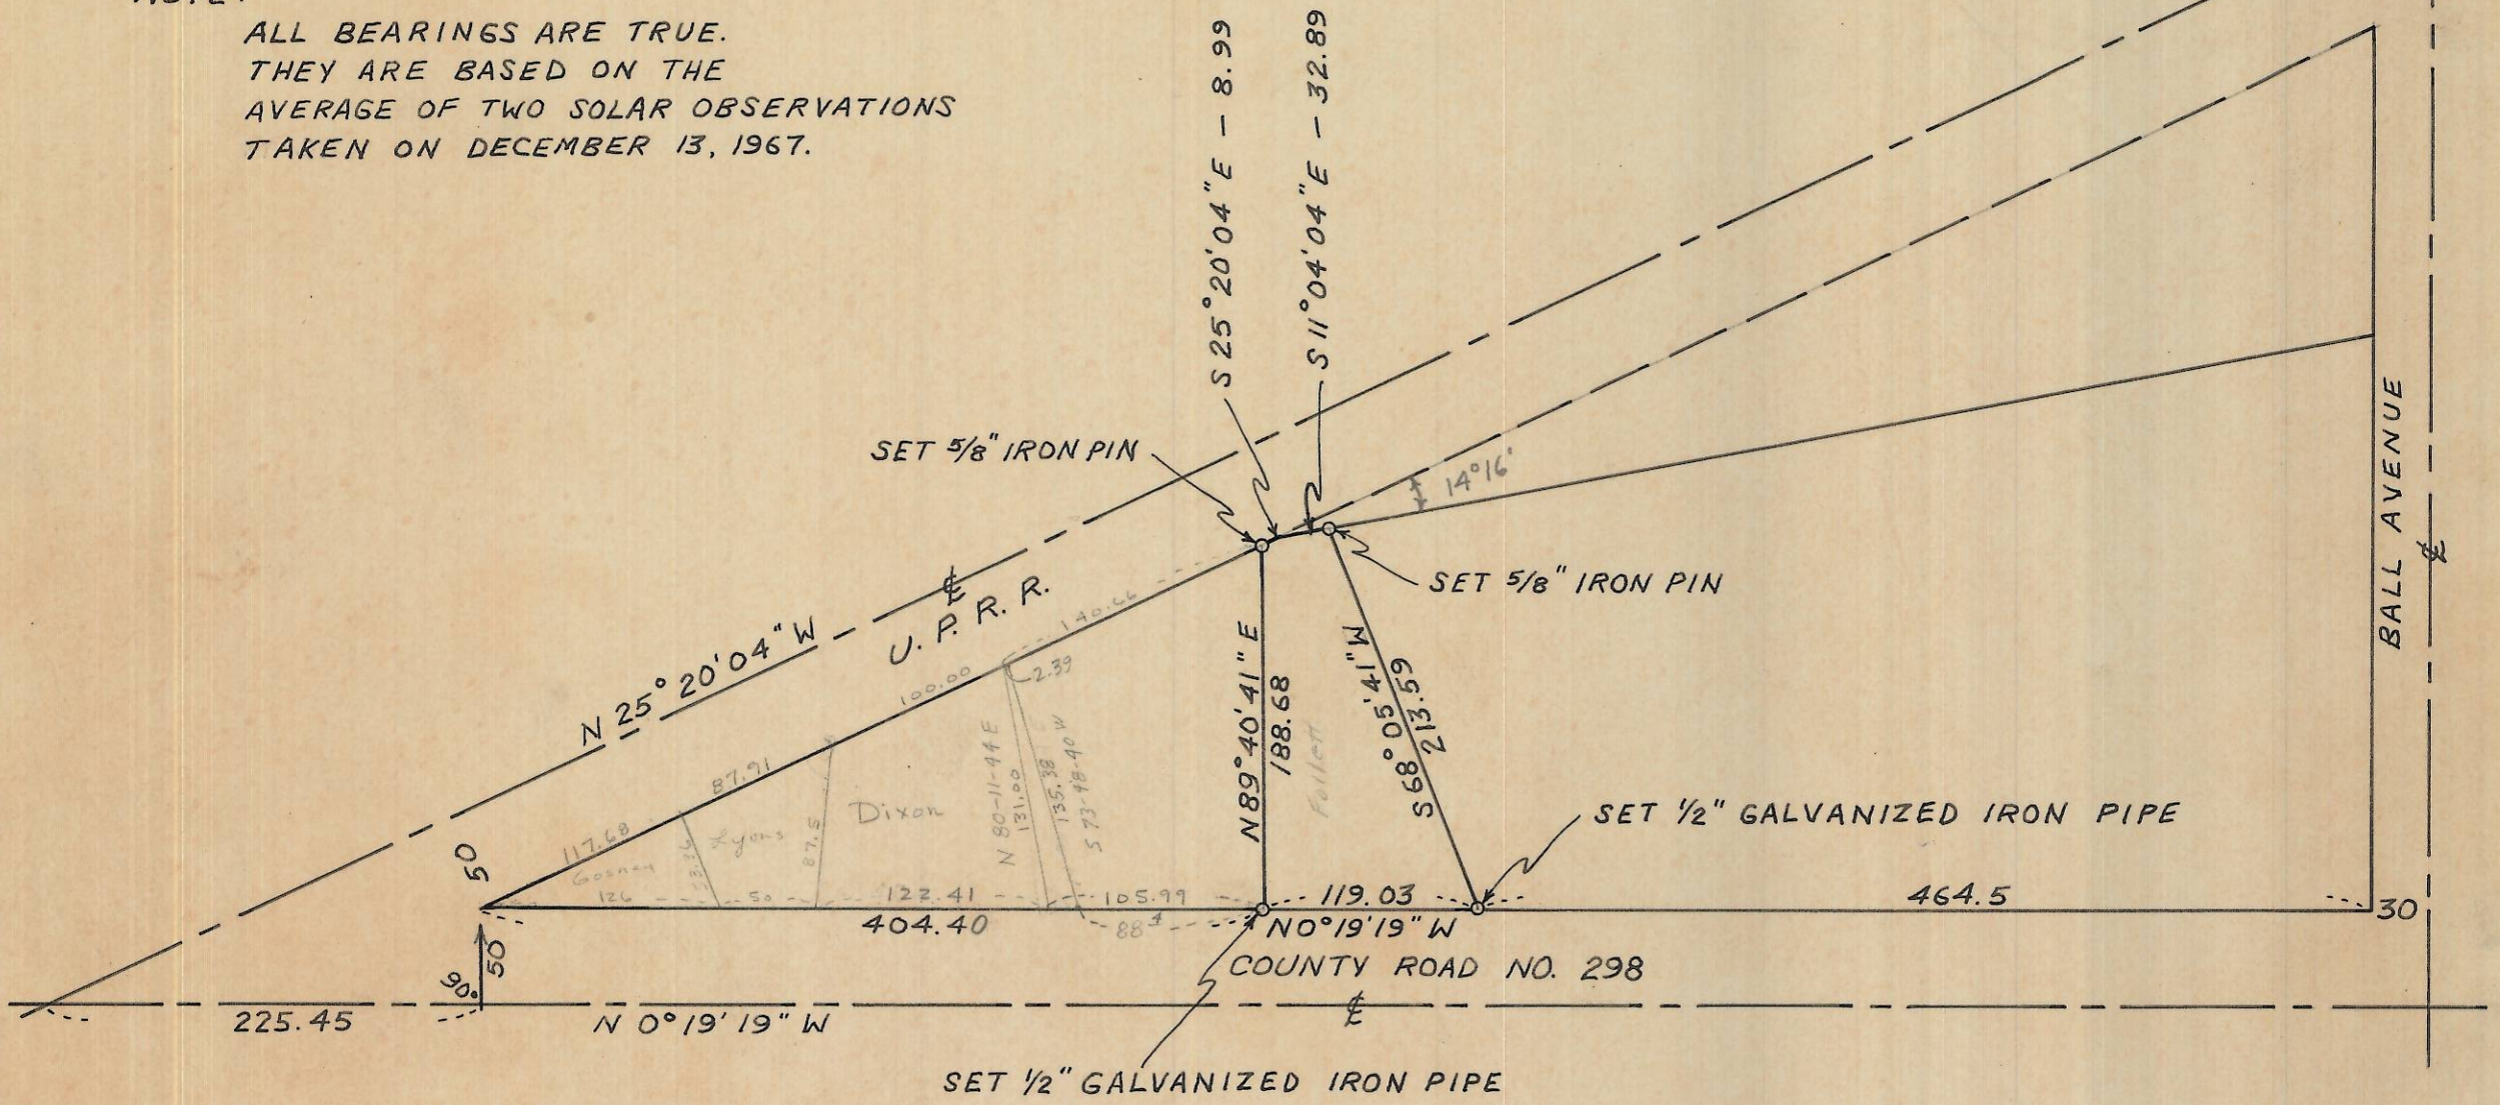

WAYNE O. HARRIS & ASSOCIATES			
SURVEY FOR			
M. G. DOTY			
PARCEL IN			
SECTION 5			
T. 3 N., R. 29 E., W.M.			
SCALE	DATE	DRN. BY	DRNG. NO.
1"=100'	2-7-68	EKO	68-200-A

03-177-A