


**NARRATIVE:**

THE PURPOSE OF THIS SURVEY IS TO STAKE THAT TRACT OF LAND DEEDED TO RASH RENTALS & INVESTMENTS ON REEL 322, PAGE 759, UMATILLA COUNTY RECORDS FOR THE POSSIBLE CONSTRUCTION OF BUILDINGS AND FENCES.

I SURVEYED THIS TRACT AND WAGNER'S TRACT IN A 1979 SURVEY FOR ROSMA AND BAKER. IN THAT SURVEY I USED MONUMENTS IN "TROTTS' ACRES" TO ESTABLISH THE NORTH LINE. IN A 1992 SURVEY FOR IKONOMOU ON THE PROPERTY TO THE NORTH I SUBDIVIDED THE NE 1/4 OF SECTION 34 AND DISCOVERED THAT THE SURVEY FOR "TROTTS' ACRES" WAS INCORRECT. IN THIS SURVEY I USED MY 1992 SURVEY FOR THE NORTH LINE AND I USED "TROTTS' ACRES" TO ESTABLISH THE EAST LINE. I FOUND MY 1979 MONUMENTS FOR THE EAST TWO CORNERS OF WAGNER AND RETRACED MY 1979 SURVEY TO SET HIS WEST CORNERS.

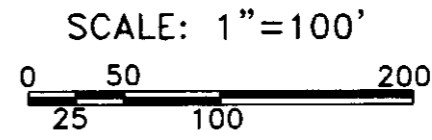

REGISTERED  
PROFESSIONAL  
LAND SURVEYOR

*G. Dennis Edwards*

OREGON  
JULY 16, 1971  
G. DENNIS EDWARDS  
9 5 1  
RENEWS 12/31/2005

**LEGEND:**

- MONUMENTS FOUND
- Ⓐ 1/2" IRON ROD SET OR USED BY ME IN 1979 SURVEY FOR ROSMA-BAKER
- Ⓑ 3/4" OR 1" IRON PIPE, PLAT OF "TROTTS' ACRES" 1952
- Ⓒ 1/2" IRON REBAR WITH PLASTIC CAP, ME 1992 SURVEY FOR IKONOMOU
- Ⓓ 5/8" IRON REBAR WITH PLASTIC CAP, ME 2004 SURVEY FOR TRANER
- Ⓔ 5/8" IRON ROD, O.D.O.T. 1981
- SET 5/8"x30" IRON REBAR WITH PLASTIC CAP #951 (000) OF RECORD, SURVEYS Ⓐ, Ⓒ OR Ⓓ

SURVEY FOR SANDY NEDDO  
IN NE 1/4, SEC. 34, T 5 N, R 28 E,  
W.M., UMATILLA COUNTY, OREGON  
3/20/05 JOB #S0411222B  
EDWARDS SURVEYING P.O. BOX 763  
541-567-3336 HERMISTON, OREGON 97838  
DRAWN BY NJF

RECEIVED BY

Umatilla County Surveyor  
Date 7-05  
Rec'd by KK  
No. 05-137-A