


NARRATIVE:

THE PURPOSE OF THIS SURVEY IS TO STAKE THOSE TRACTS OF LAND DEEDED TO JUAN ANGEL ON A DEED RECORDED ON REEL 484, PAGE 66 AND ON A LAND SALE CONTRACT RECORDED ON REEL 447, PAGE 757, UMATILLA COUNTY DEED RECORDS.

BOTH DEEDS SAY THE DIVIDING LINE BETWEEN THEM IS A LINE WHICH LIES 10 FEET EAST OF THE WEST LINE OF LOT 2, BLOCK 1, BUT I STAKED SAID LINE AT 12 FEET EAST OF SAID WEST LINE TO ALLOW FOR A FUTURE LOT LINE ADJUSTMENT TO CLEAR THE EAVES OF A CAR PORT.

I BASED THIS SURVEY ON MY 2002 SURVEY FOR WILLIAMS SOUTH OF BLOCK 3. THE NORTH LINE OF BLOCK 1 IS WITHIN ONE TENTH OF A FOOT OF WHAT THE ORIGINAL PLAT SHOWS.

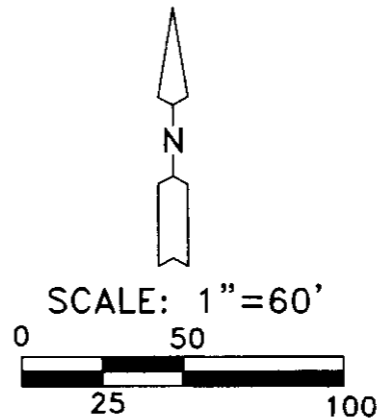

REGISTERED
PROFESSIONAL
LAND SURVEYOR

G. Dennis Edwards

OREGON
JULY 16, 1971
G. DENNIS EDWARDS
9 5 1
RENEWS 12/31/2005

LEGEND:

- FOUND MONUMENTS AS NOTED
- SET 5/8"X30" IRON REBAR WITH PLASTIC CAP #951
- [000] OF RECORD, PLATS OF "HALSTEAD'S ADDITION" & "HALSTEAD'S 2ND ADDITION"

SURVEY FOR JUAN ANGEL
IN BLK. 1, "HALSTEAD'S 2ND ADDITION",
CITY OF ECHO, IN SE 1/4, SEC. 16, T 3 N, R 29 E,
W.M., UMATILLA COUNTY, OREGON
6/20/2005 JOB# S0506094
EDWARDS SURVEYING P.O. BOX 763
541-567-3336 HERMISTON, OREGON 97838
DRAWN BY NJF

RECEIVED BY
Umatilla County Surveyor
Date 7-05
Rec'd By KE
No. 05-142-A