

**NARRATIVE:**


THE PURPOSE OF THIS SURVEY IS TO DO A BOUNDARY LINE ADJUSTMENT TO ADD PART OF LOT 1, BLOCK 7, "HAT ROCK TRACTS", UMATILLA COUNTY, OREGON, (AKA TAX LOT 1600 AND DESCRIBED IN A DEED TO JOHN AND JACKIE SIELAFF RECORDED ON DOCUMENT 2004-4600676 UMATILLA COUNTY DEED RECORDS) TO TAX LOT 1603 WHICH IS DESCRIBED IN A DEED TO JOHN AND JACKIE SIELAFF ON REEL 193, PAGE 1025, UMATILLA COUNTY DEED RECORDS AND IS THE SOUTH HALF OF LOT 4 AND ALL OF LOT 5, OF SAID BLOCK 7.

I SURVEYED SAID LOT 1 IN APRIL 2005 FOR DELANEY AND SIELAFF AND THIS SURVEY AND THE BEARINGS ARE BASED ON THAT ONE WHICH WAS BASED ON THE PLAT OF "HAT ROCK TRACTS".


REGISTERED  
PROFESSIONAL  
LAND SURVEYOR

*G. Dennis Edwards*

OREGON  
JULY 16, 1971  
G. DENNIS EDWARDS  
9 5 1  
RENEWS 12/31/2005

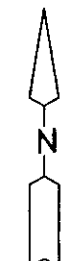

SCALE: 1"=60'

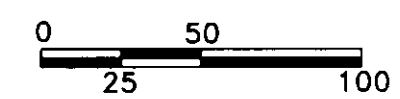

**LEGEND:**

- MONUMENTS FOUND AS NOTED OR (A) 5/8" IRON REBAR MY MAY 2005 SURVEY FOR DELANEY & SIELAFF
- SET 5/8"X30" IRON REBAR WITH PLASTIC CAP #951
- ⊙ COMPUTED LOCATION
- (000) PLAT OF "HAT ROCK TRACTS"

SURVEY FOR JOHN SIELAFF  
IN LOT 1, BLK. 7, "HAT ROCK TRACTS",  
IN NE 1/4, SEC. 15, T 5 N, R 29 E, W.M.,  
UMATILLA COUNTY, OREGON  
11/17/2005 JOB# S0504062A  
EDWARDS SURVEYING P.O. BOX 763  
541-567-3336 HERMISTON, OREGON 97838  
DRAWN BY NJF/JMC

RECEIVED BY

Umatilla County Surveyor

Date 12-05

Rec'd by KK

No. 05-200-A