


J.E. OLINGER SUB-DIVISION

ON WALLA WALLA RIVER
Scale 1"=100' S.W. 1/4 SEC. 18, T.5N., R.36E.W.M.

Survey by Jack M. Fhearn
1922, J.E. Olinger - 1936.

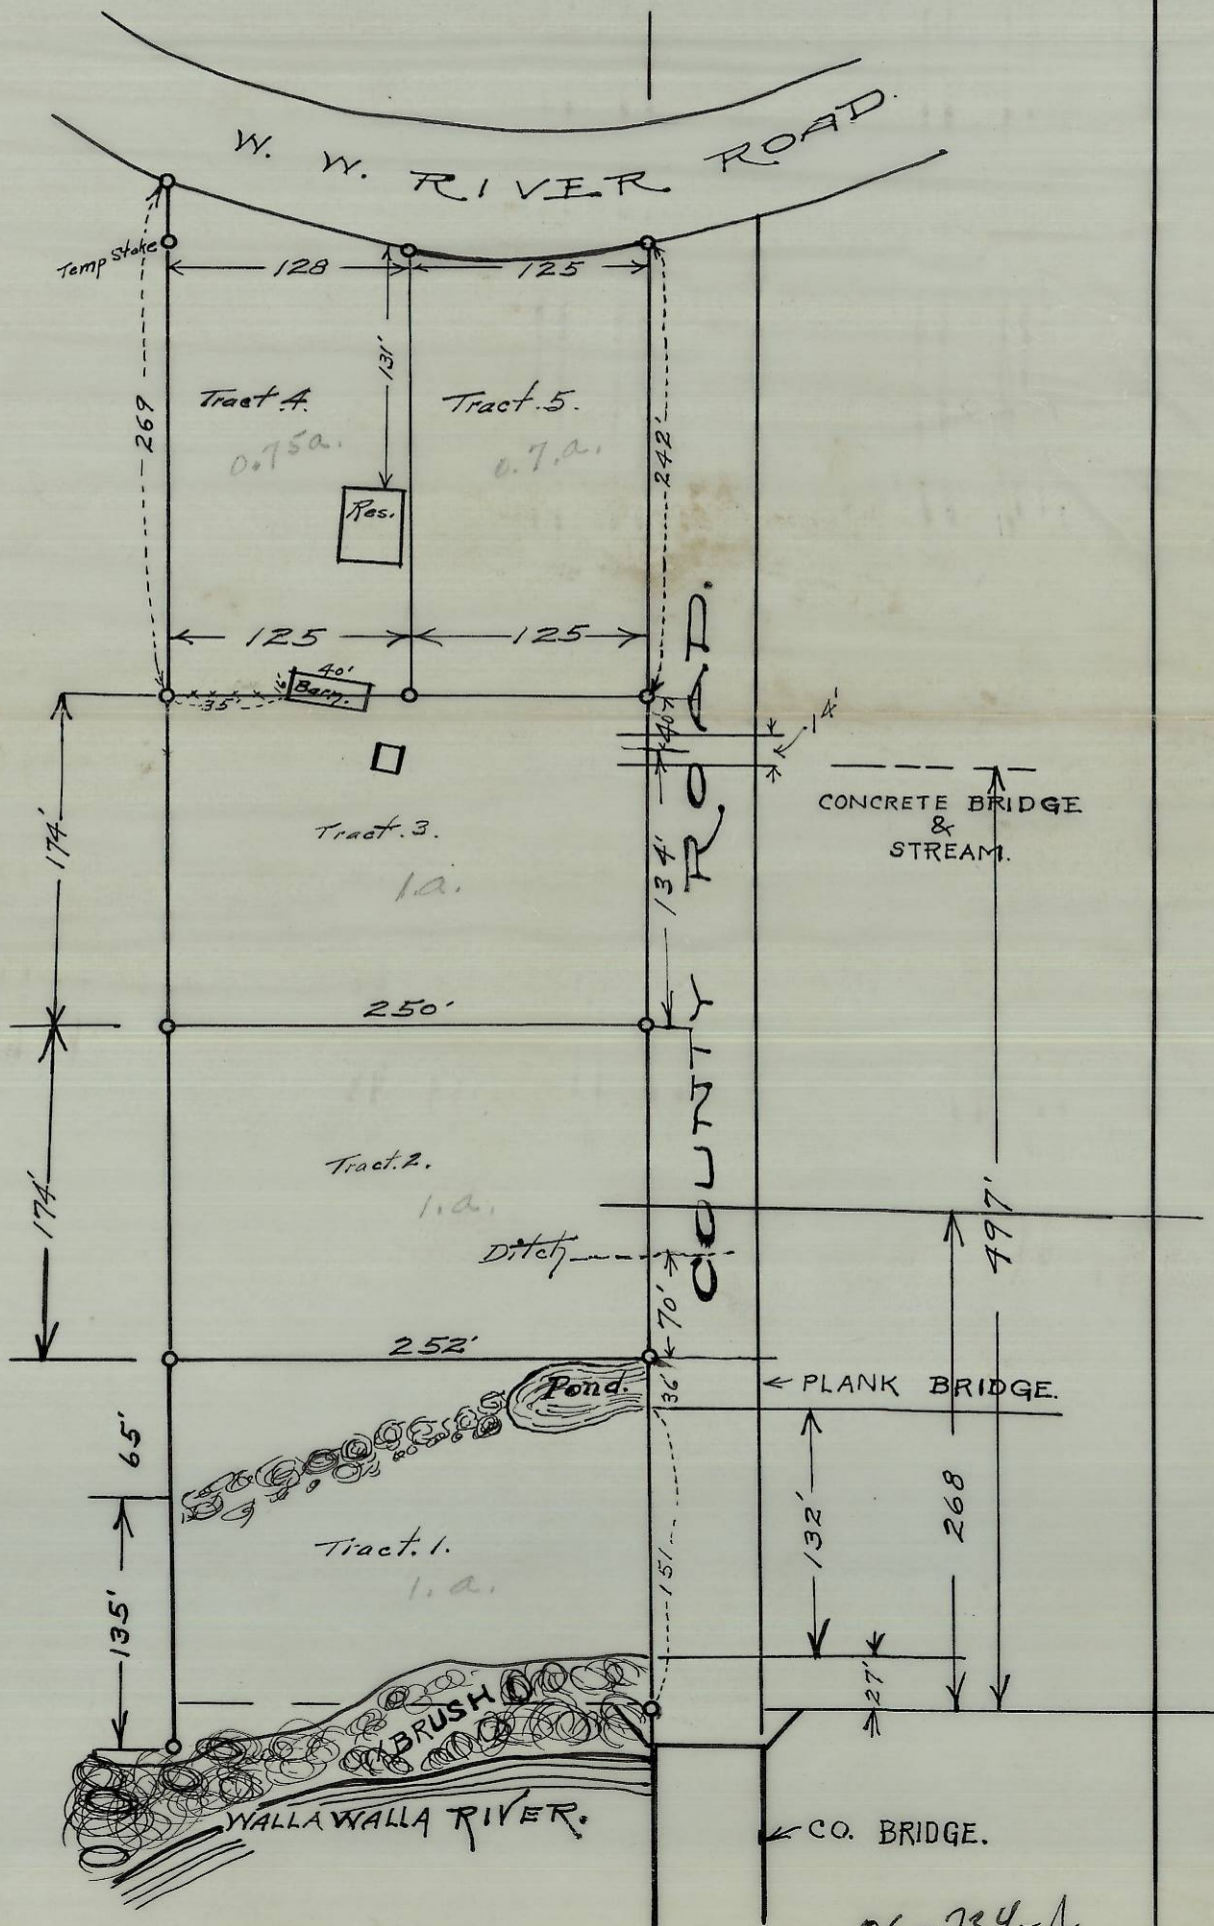

06-234-A