

**NARRATIVE:**


THE PURPOSE OF THIS SURVEY IS TO STAKE LOT 12, BLOCK 1, "McNARY TOWNSITE DIVISION 2", FOR A PENDING SALE AND SO PROPER SETBACKS CAN BE ESTABLISHED FOR A NEW HOME.

I RETRACED HARRIS' 1974 PLAT TO ESTABLISH THE MISSING CORNER OF THIS LOT. THE SOUTH TWO MONUMENTS ARE ABOUT A FOOT BELOW THE SURFACE AND THE SOUTHWEST CORNER IS UNDER A CONCRETE DRIVE WAY.


REGISTERED  
PROFESSIONAL  
LAND SURVEYOR

*G. Dennis Edwards*

OREGON  
JULY 16, 1971  
G. DENNIS EDWARDS  
9 5 1  
RENEWS 12/31/2007

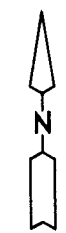

SCALE: 1"=30'

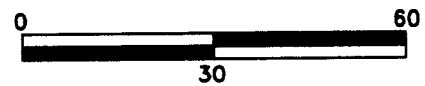

**LEGEND:**

- FND. 1/2" IRON REBAR, HARRIS 1974 PLAT OF "McNARY TOWNSITE DIV. 2"
- SET 5/8"X30" IRON REBAR WITH PLASTIC CAP #951 (000) OF RECORD, PLAT OF "McNARY TOWNSITE DIV. 2"

SURVEY FOR DALE CHAPMAN C/O AMER. WEST REALTY IN LOT 12, BLK. 1, "McNARY TOWNSITE DIV. 2," CITY OF UMATILLA, IN NE 1/4 SEC. 15, T 5 N, R 28 E, WILLAMETTE MERIDIAN, UMATILLA COUNTY, OREGON 06/22/2006 JOB# S0606099 EDWARDS SURVEYING P.O. BOX 763 541-567-3336 HERMISTON, OREGON 97838 DRAWN BY JMC

RECEIVED BY

Umatilla County Surveyor

Date 8-06

Rec'd By KK

No. 06-495-A