


NARRATIVE:
 THE PURPOSE OF THIS SURVEY IS TO FIND AND OR SET THE CORNERS OF LOT 6, BLOCK "B", EKLEBERRY TRACTS SO A HOME CAN BE SET ON IT WITH THE PROPER SETBACKS.
 I RETRACED FRALEY'S 1950 PLAT TO SET THE MISSING NE CORNER.

REGISTERED
 PROFESSIONAL
 LAND SURVEYOR

G. Dennis Edwards

OREGON
 JULY 16, 1971
 G. DENNIS EDWARDS
 9 5 1
 RENEWS 12/31/2007

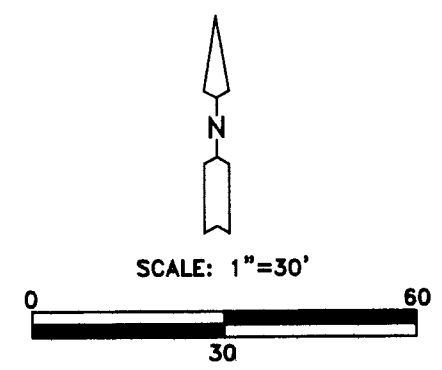

LEGEND:
 ● FOUND 1/2" IRON RODS OF "EKLEBERRY TRACTS" FRALEY 1950
 ○ SET 5/8"X30" IRON REBAR WITH PLASTIC CAP #951
 (000) OF RECORD PLAT OF "EKLEBERRY TRACTS"

SURVEY FOR SAM WHITLOCK
 IN BLK "B," "EKLEBERRY TRACTS," IN SE 1/4 SEC. 9,
 T 4 N, R 28 E, W.M., UMATILLA COUNTY, OREGON
 06/29/2006 JOB# S0606106
 EDWARDS SURVEYING P.O. BOX 763
 541-567-3336 HERMISTON, OREGON 97838
 DRAWN BY JMC

RECEIVED BY
 Umatilla County Surveyor
 Date 8-06
 Rodd By KK
 No. 06-494-A