


Found iron pin
in Highway

Found concrete monument

Found 3/4" copper pipe in Co. road

Found iron pin
in Highway

Found iron pin

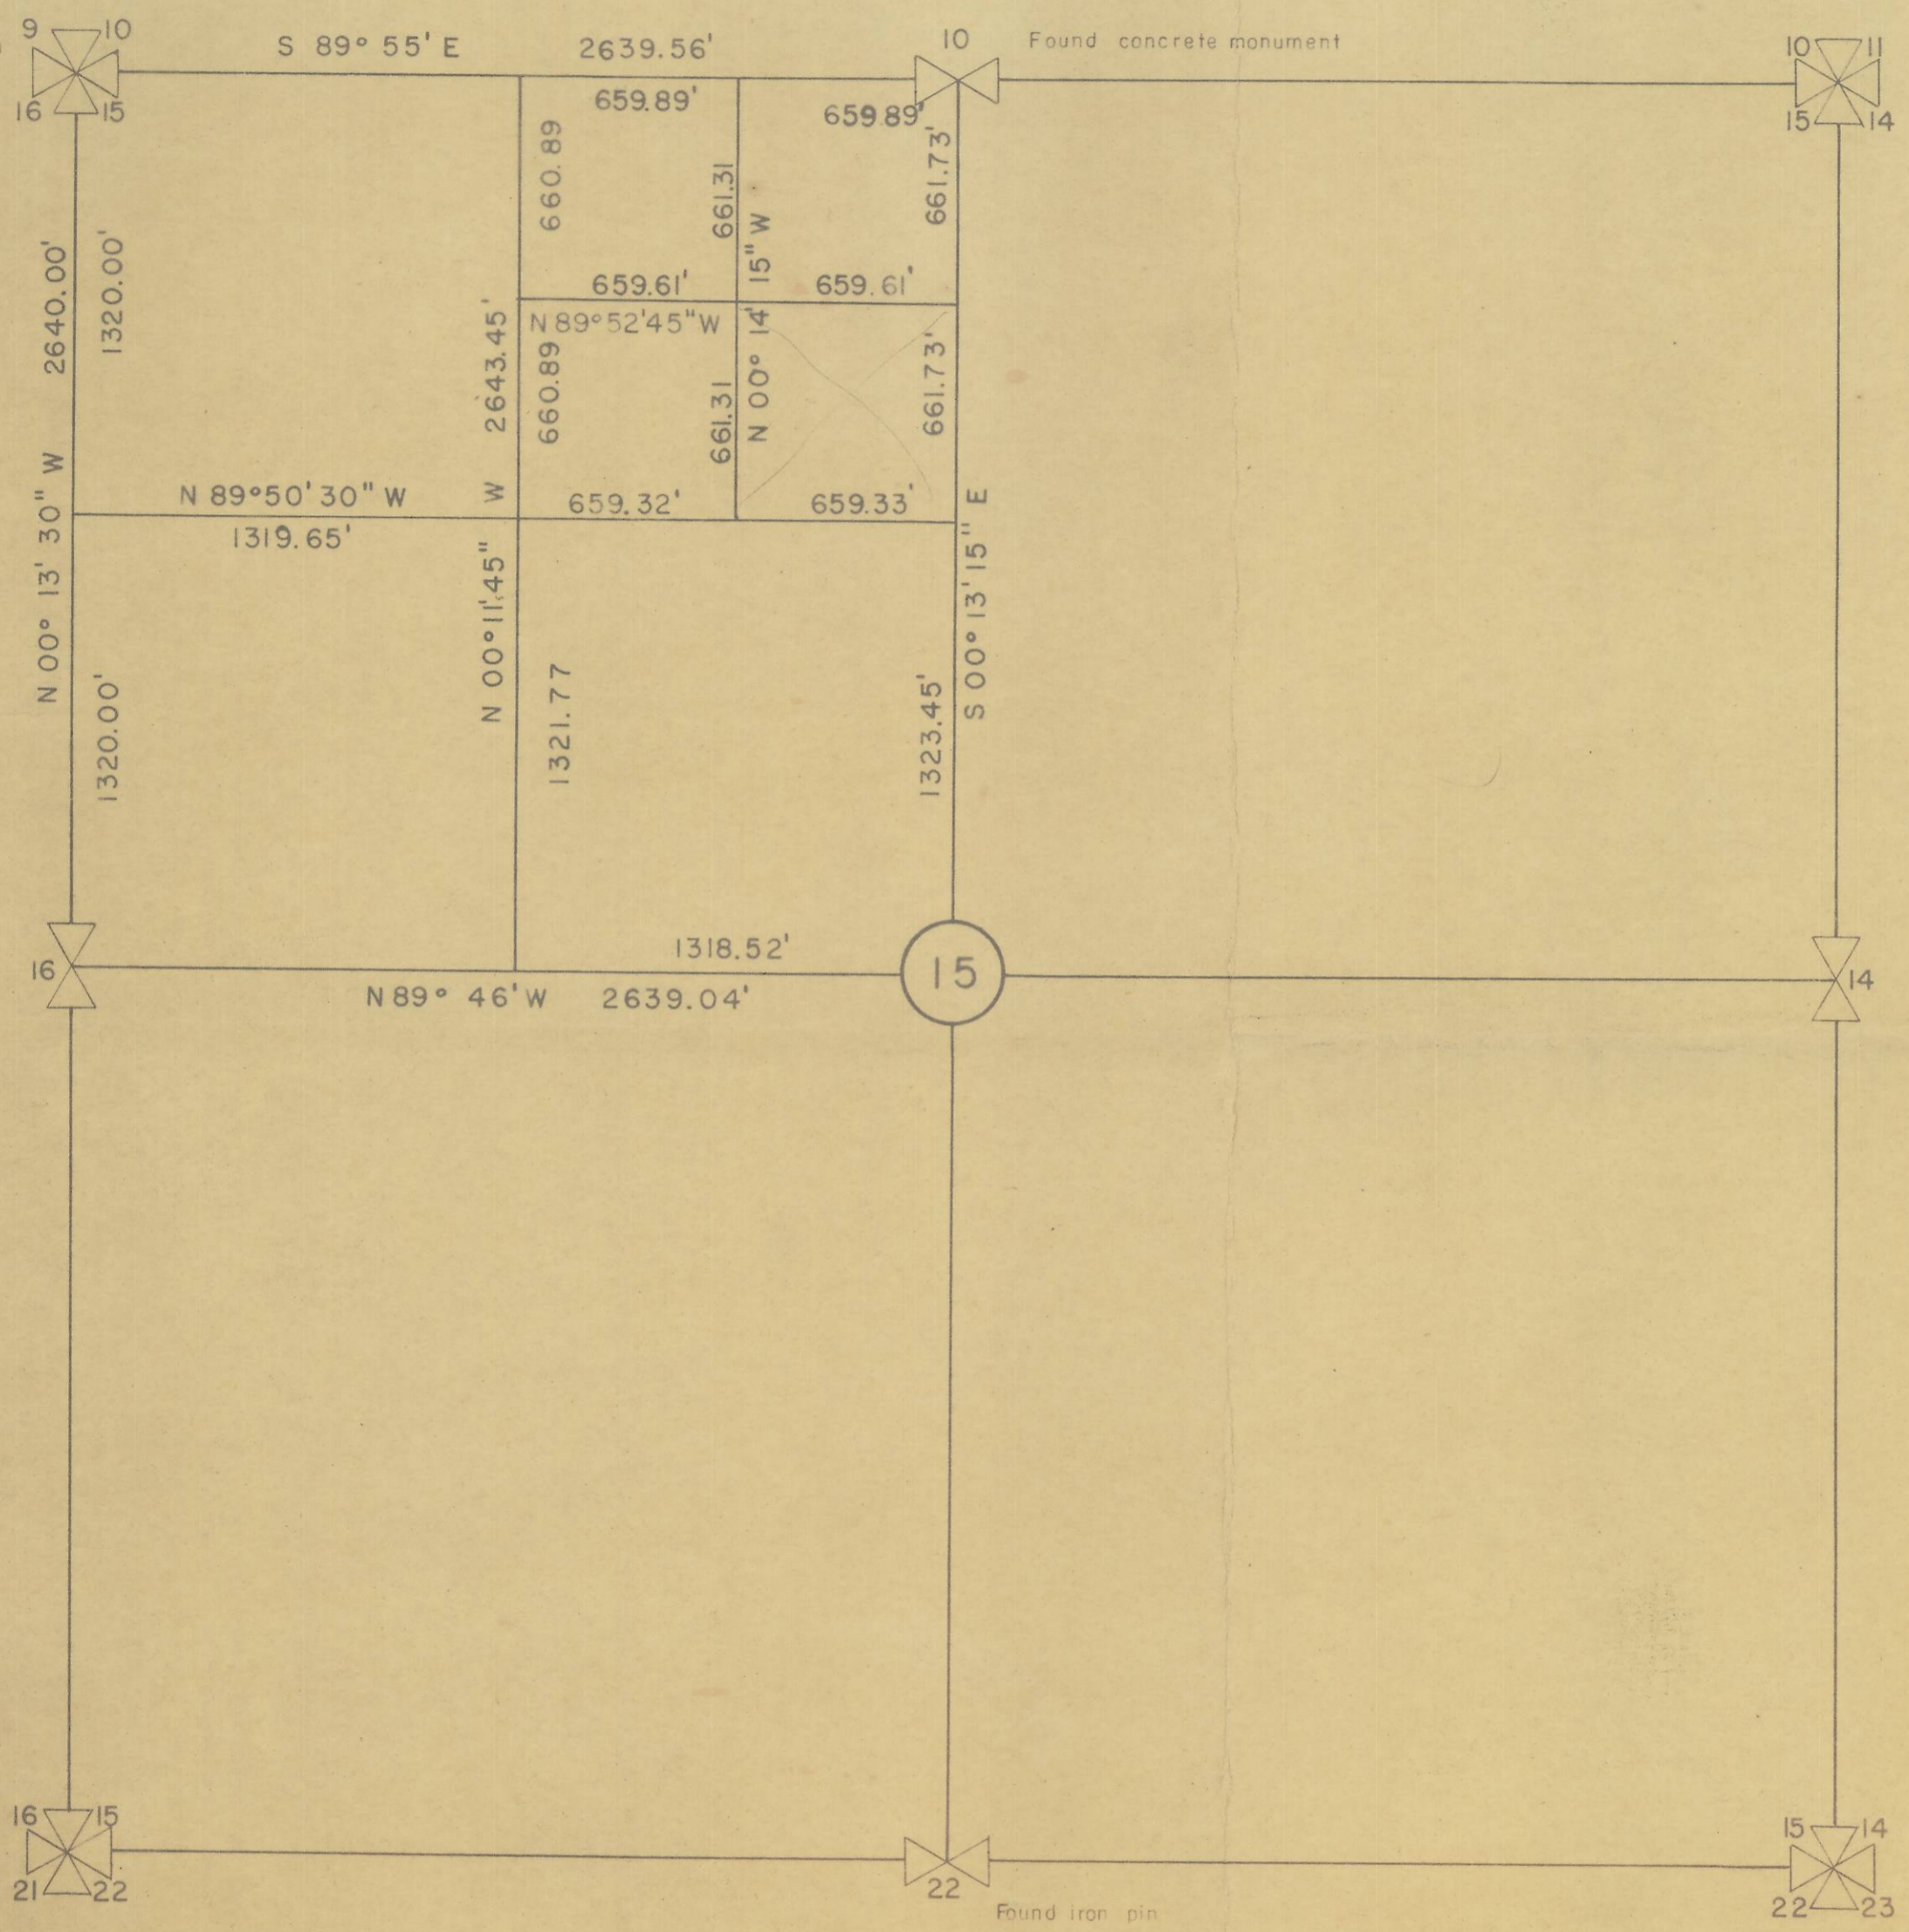

FRANK R. OFNER
 REGISTERED ENGINEER
 PENDLETON OREGON

SURVEY FOR JCSAM NYE
 SE 1/4 NE 1/4 NW 1/4
 SEC. 15, T. 4 N., R. 28 E.,
 W.M.

11-19-49 FRO 1"=50 Ft. CE-23-49-1

08-16-A
 4N 28 15 BA