

SURVEYOR'S NARRATIVE:

THE PURPOSE OF THIS SURVEY IS TO DO A BOUNDARY LINE ADJUSTMENT TO ADD PART OF TAX LOT 1505 TO TAX LOT 1702. TAX LOT 1505 IS DESCRIBED IN A DEED TO THE KERRY W. & VENDLA M. KARLSON FAMILY TRUST ON INSTRUMENT # 2003-4360372. TAX LOT 1702 IS DEEDED TO THE SAME FAMILY TRUST ON INSTRUMENT # 2004-4640671 AND IN DEED REEL 281, PAGE 1443, UMATILLA COUNTY DEED RECORDS. I SURVEYED THIS PROPERTY IN 1976 AND 1977 SURVEYS FOR WES CRUIKSHANK AND THIS SURVEY AND THE BEARINGS ARE BASED ON THOSE SURVEYS.

THIS SURVEY WAS CONDUCTED WITH A HIPER + TOPCON G.P.S.

REGISTERED
PROFESSIONAL
LAND SURVEYOR


G. Dennis Edwards

OREGON
JULY 16, 1971
G. DENNIS EDWARDS
9 5 1
RENEWS 12/31/2009

SURVEY FOR KERRY KARLSON
IN SW 1/4, SE 1/4, SEC. 34, T 5 N,
R 28 E, W.M., UMATILLA COUNTY, OREGON
10/21/2008 JOB# S0810134
EDWARDS SURVEYING P.O. BOX 763
541-567-3336 HERMISTON, OREGON 97838
DRAWN BY JMC RECEIVED BY

LEGEND:

- FND. 1/2" I. REBAR ME 1977 SURVEY FOR CRUIKSHANK, UNLESS NOTED OTHERWISE
- SET 5/8"X30" IRON REBAR WITH PLASTIC CAP #951
- ⊙ COMPUTED FROM MY 1976 & 1977 SURVEYS FOR CRUIKSHANK
- (000) OF RECORD, MY 1977 SURVEY FOR CRUIKSHANK
- [000] OF RECORD, MY 1976 SURVEY FOR CRUIKSHANK

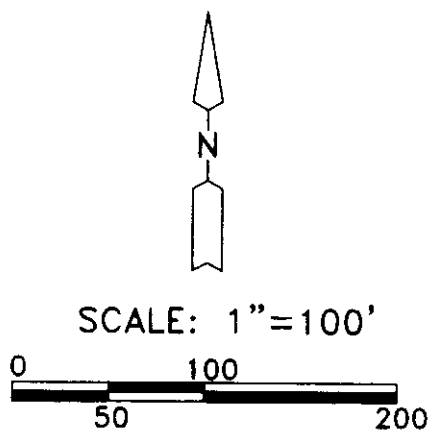

Umatilla County Surveyor
Date 01-09
Rec'd By JK
No. 09-02-A