

SURVEYOR'S NARRATIVE:

THE PURPOSE OF THIS SURVEY IS TO SET THE MISSING EAST CORNERS OF A TRACT OF LAND SURVEYED BY GARY WAGNER IN A 1999 BOUNDARY LINE ADJUSTMENT SURVEY FOR COPPER BASIN CONSTRUCTION IN LOTS 11 AND 12 "UMATILLA HEIGHTS" SUBDIVISION.


I RETRACED WAGNER'S SURVEY TO SET THE MISSING MONUMENTS.

I USED A TOPCON HIPER+ G.P.S. TO CONDUCT THIS SURVEY.

REGISTERED
PROFESSIONAL
LAND SURVEYOR

G. Dennis Edwards

OREGON
JULY 16, 1971
G. DENNIS EDWARDS
9 5 1
RENEWS 12/31/2011

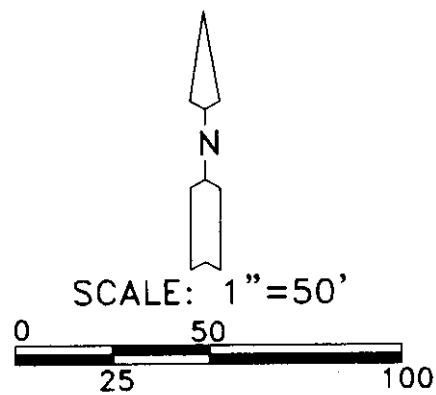

LEGEND:

- FND. 5/8" I. REBAR, WAGNER 1999 ORIG. PLAT OF "UMATILLA TERRACE," B.13 P. 145, UNLESS NOTED OTHERWISE
- SET 5/8"X30" IRON REBAR WITH PLASTIC CAP #951
- ⊙ COMPUTED LOCATION

SURVEY FOR G. DENNIS EDWARDS
 IN LOTS 11 & 12, "UMATILLA TERRACE,"
 IN E 1/2, SEC. 18, T 5 N, R 28 E,
 W.M., UMATILLA COUNTY, OREGON
 5/14/2011 JOB# S1005027
 EDWARDS SURVEYING P.O. BOX 763
 541-567-3336 HERMISTON, OREGON 97838
 DRAWN BY JMC

Date 6-11
 Red & By KA
 No. 11-71-A