

T5N R35E  
T4N R35E

County Road

ROBERT COPPOCK


E. A. DUDLEY

TAYLOR

ROBERT COPPOCK

ROBERT COPPOCK

R. R. GALLAHER

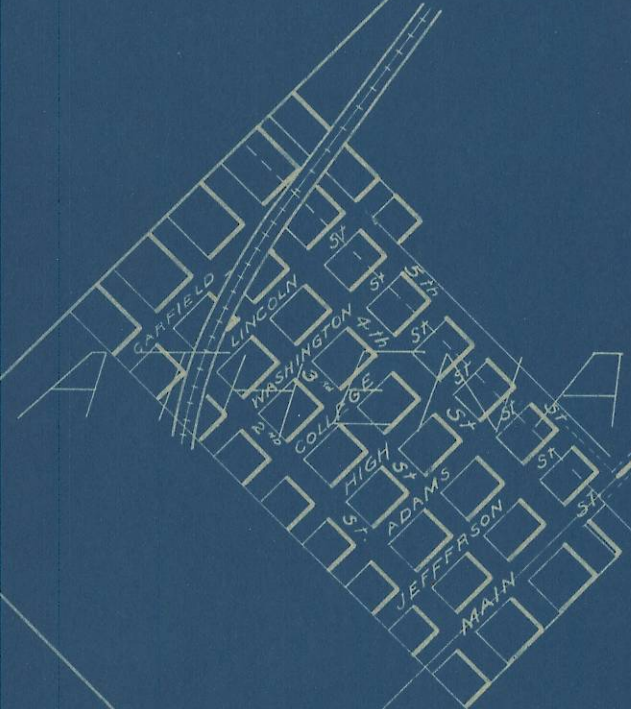

DAVID

Pipe Line

G. W. LIEUALLEN

County Road

G. W. LIEUALLEN

Reservoir

Creek

Springs

R. R. GALLAHER

MAP  
Showing Location of Pipe Line  
For Gravity Water Supply System  
for the City of  
ATHENA OREGON  
Aug. 5<sup>th</sup> 1905  
Scale 1 inch = 1000 ft. G. N. Miller  
Civil & Hyd. Engr.

Filed for Record Aug. 24, 1905 at 9:35 P.M.  
And recorded in Book 2 of Plats at Page 66

Hartman Abstract Co,  
Pendleton Oregon

11-143-A  
4N 35 19

4N35